

LAND CORNER RECORDATION CERTIFICATE Filing Requirement of Act 74, Mich. P.A. 1970

For corners in MARQUETTE (County) Located In: Corner Code # 1. Public Land Survey T 47N R 24W C-6 2. Property Controlling in Section S T R 3. Miscellaneous Property in Sec. S T R 4. Lot No. , Recorded Plat 5. Private Claims

Register of Deeds REGISTER OF DEEDS

NUMBER R 2 PAGE 130

Register of Deeds Stamp & File Number

I, GERALD W. CARLSON, in a field survey on SEPTEMBER 23rd, 19 98, do hereby state that under requirements of P.A. 74, Michigan P.A. of 1970, the corner points mentioned in lines 1 and 2 above were in conformance with regulations and rules therefore as required in the current manual of survey instructions of the United States Department of the Interior, Bureau of Land Management or by a decree of a Court of Law and/or that the corner points mentioned in lines 3, 4 and 5 above were in conformance with the rules of the Michigan Board of Land Surveyors or by a Decree of a Court of Law; established, re-established, monumented, recovered, found as expressed below:

NOTE: Not more than 2 corners, all in the same town and range, may be recorded on this certificate.

A. Description of original monument and accessories and/or subsequent restoration: C-6: Quarter Corner common to Sections 17 and 18. 1845: A.D. Sullivan's original subdivision survey notes describe the corner monument as a wood post referenced by: 20" Birch S20E, 22 L 30" Hemlock N53W, 47 L

No Date: Source unknown, map recorded in L. 315, Deeds, Pg. 179 indicates the corner. No description of corner object or accessories given.

1976: Property Description Maps recorded by Robert F. Cambensy, PS No. 19616 L. 322, Deeds, Pg.203 and L. 322 Deeds, Pg. 154 indicates the corner as a set 5/8" x 24" Re-rod at fence corner where four fences intersect. Location witnessed as correct by Alva and Wm. J. Mennhenick. Distance N01°25'43"W, 2624.06' to the Northeast Corner Section of 18.

1977: Survey Map recorded by Robert F. Cambensy, PS No. 19166 in L.97, MR, Pg.992-995 indicates the corner. No description of corner object or accessories given. Distance N01°25'43"W, 2624.06' to the Northeast Corner of Section 18. (SEE REVERSE SIDE)

B. Description of corner evidence found and/or method applied in restoring or reestablishing corner: C-6: 1998: No original corner evidence found. Found and accepted a 5/8" Iron w/ Cap No. 19616 at fence corner flush with ground. Bearings and distances check well with those as shown on Minard LCRC and Carlson Certificate of Survey. Checked Line Call: South 17.00 chains [1122']. Measured with hip chain, South along old 4-wire fence 1125' to the North Bank of stream. Distance North is 2623.47. Distance South is 2616.31'.


C. Description of monument for corner and accessories established to perpetuate locating the position of the corner: C-6: 1998: Replaced found 5/8" Iron w/ Cap No. 19616 with a 2 3/8" O.D. aluminum pipe capped with a 3 1/4" diameter aluminum tablet Marquette County Survey Monument stamped to identify the corner. Monument is flush with ground. Measured found references: 17" Poplar S10E, 9.21' 8" W. Birch N50W, 14.12' 10" W. Birch N72E, 17.71' Established references: 9" Maple S38E, 15.28' 6" Maple S80E, 26.43'

Green Steel Sign Post w/ Yellow Survey Marker Sign N29E, 2.25'

Note: Bearing trees have painted face, butt, and side nail blazes, d.h. measuring nails, and stamped B.T. Tags affixed.

Bk. 12, Pg. 70-73

RATIFIED BY PEER GROUP P.A. 345 OF 1990 DATE 12/21/98

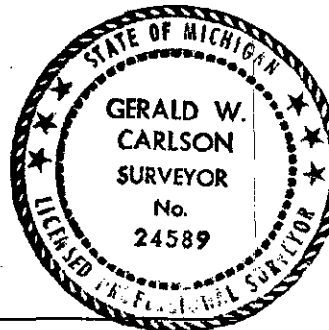

Signed by Gerald W. Carlson Date 12-28-98

C-6

PART A CONT.:

1983: A LCRC recorded by James L. Minard, PS No. 30091 in L. 5 RC, Pg. 30 indicates the corner as a found 3/4" Rebar w/cap R.L.S. No. 19616 at fence corner, used for survey in Section 18. Referenced by:

Nail in 14" Poplar	N	4.29'	Nail in 14" Poplar	S10E,	9.11'
Nail in 10" W. Birch	N72E,	17.56'	P.K. Nail in 10" W. Birch	N50W,	14.12'

1992: A unrecorded Certificate of Survey by Gerald W. Carlson, PS No. 24589 indicates the corner as a found 5/8" Iron w/cap R.L.S. No. 19166. Distance S00°11'00"E, 2616.23' to the S.W. Corner of Section 17. Referenced by:

8" W. Birch	N54W,	14.10'	20" Poplar	S12E,	9.20'
10" W. Birch	N71E,	17.58'	Fence Post	S45W,	0.15'

CITY OF
RECORDATION SECTION

SEP 19 1999

SECTION