

SURVEY & REMONUMENTATION

MARQUETTE COUNTY
MICHIGAN
RECEIVED FOR RECORD

JOB NUMBER: 94030
SHEET NO. : 1-471

APR 28 1995 LAND CORNER RECORDATION CERTIFICATE
Filing Requirement of Act 74, Mich. P.A. 1970

1994 DEC 28 PM 5:55

For corners in

COMMISSION

Patricia A. Menley
REGISTER OF DEEDS

| | | |
|---------------------------------------|---------------------------|---------------|
| | Located In: | Corner Code # |
| MARQUETTE <small>(County)</small> | | |
| 1. Public Land Survey | T <u>47N</u> R <u>24W</u> | G-5 |
| | T _____ R _____ | _____ |
| | T _____ R _____ | _____ |
| | T _____ R _____ | _____ |
| 2. Property Controlling in Section | S _____ T _____ R _____ | _____ |
| | S _____ T _____ R _____ | _____ |
| 3. Miscellaneous Property in Sec. | S _____ T _____ R _____ | _____ |
| | S _____ T _____ R _____ | _____ |

LIBER **1** PAGE **142**
Register of Deeds Stamp & File Number

4. Lot No. _____, Recorded Plat _____
5. Private Claims _____

| | | | | | | | | | | | | | |
|----|----|----|----|----|----|----|---|---|---|---|---|---|---|
| | A | B | C | D | E | F | G | H | I | J | K | L | M |
| 2 | 6 | 5 | 4 | 3 | 2 | 1 | | | | | | | |
| 3 | | | | | | | | | | | | | |
| 4 | 7 | 8 | 9 | 10 | 11 | 12 | | | | | | | |
| 5 | | | | ● | | | | | | | | | |
| 6 | 18 | 17 | 16 | 15 | 14 | 13 | | | | | | | |
| 7 | | | | | | | | | | | | | |
| 8 | 19 | 20 | 21 | 22 | 23 | 24 | | | | | | | |
| 9 | | | | | | | | | | | | | |
| 10 | 30 | 29 | 28 | 27 | 26 | 25 | | | | | | | |
| 11 | | | | | | | | | | | | | |
| 12 | 31 | 32 | 33 | 34 | 35 | 36 | | | | | | | |
| 13 | | | | | | | | | | | | | |

I, GERALD W. CARLSON, in a field survey on Monday, December 12, 1994, do hereby certify that under requirements of P.A. 74, Michigan P.A. of 1970, the corner points mentioned in lines 1 and 2 above were in conformance with regulations and rules therefore as required in the current manual of survey instructions of the United States Department of the Interior, Bureau of Land Management or by a decree of a Court of Law and/or that the corner points mentioned in lines 3, 4 and 5 above were in conformance with the rules of the Michigan Board of Land Surveyors or by a Decree of a Court of Law; established, re-established, monumented, re-monumented, recovered, found as expressed below:

NOTE: Not more than 4 corners, all in the same town and range, may be recorded on this certificate.

A. Description of original monument and accessories and/or subsequent restoration:

G-5: NE Corner Section 16, T47N-R24W. 1845: A.D. Sullivan's 1988: Survey by William R. Donnan indicated the SE corner original subdivision survey notes describe the corner monument as a wood post referenced by:
 4" Spruce S30E 35.10' 8" Birch N30E 1.61'
 14" Hemlock N55E, 30 L 12" Hemlock S46W 16 L 8" Maple N70W 21.79' 6" Maple S35W 13.85'

B. Description of corner evidence found and/or method applied in restoring or reestablishing corner:

1994: Found and accepted 5/8" rerod as referenced in Part "A" above. Distance West is 2603.63' and distance East is 2640.05'. Also found a 5/8" rerod with RLS cap 17618 at the East 1/16 Corner to Sections 9 and 16, 0.06' North of Line and 0.29' West of split between N 1/4 Corner and NE Corner of Section 16.


RATIFIED BY PEER GROUP.

P.A. 345 OF 1990

Larry J. Bussone
DATE Nov 7, 1994

C. Description of monument for corner and accessories established to perpetuate locating the position of the corner:

1994 - Replaced a 5/8" iron with a 2 1/2" diameter aluminum pipe capped with a 3 1/4" diameter aluminum tablet Marquette County Survey Monument stamped to identify the corner referenced by nails in:
 10" White Birch N39E 1.63 ft. Donnan NBT
 8" Spruce S35E 35.26 ft. Donnan NBT
 7" Maple S19W 13.74 ft. Donnan NBT
 10" Maple N72W 21.47 ft. Donnan NBT
 Steel sign post South 1.0 ft.
 Monument is 0.30 ft. above ground
 Bk. 5, Pg. 109

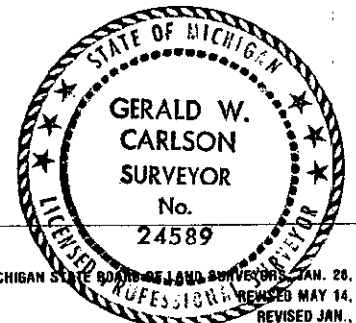

Signed by Gerald W. Carlson Date 12-22-94

Surveyor's Michigan License No. 24589