

# SURVEY & REMONUMENTATION

APR 28 1995

JOB NUMBER: 94030  
SHEET NO. : 1-481

## LAND CORNER RECORDATION CERTIFICATE COMMISSION Filing Requirement of Act 74, Mich. P.A. 1970

MARQUETTE COUNTY  
MICHIGAN  
RECEIVED FOR RECORD  
1994 DEC 28 PM 5:56

*Patricia A. Hanley*  
REGISTER OF DEEDS

For corners in

	MARQUETTE (County)	Located In:	Corner Code =#
1. Public Land Survey	T <u>47N</u> R <u>24W</u>		<u>M-8</u>
		T _____ R _____	_____
		T _____ R _____	_____
		T _____ R _____	_____
2. Property Controlling in Section	S _____ T _____ R _____		_____
	S _____ T _____ R _____		_____
3. Miscellaneous Property in Sec.	S _____ T _____ R _____		_____
	S _____ T _____ R _____		_____

LIBER **1** PAGE **152**  
Register of Deeds Stamp & File Number

4. Lot No. \_\_\_\_\_, Recorded Plat \_\_\_\_\_  
5. Private Claims \_\_\_\_\_

	A	B	C	D	E	F	G	H	I	J	K	L	M
2	6	5	4	3	2	1							
3													
4	7	8	9	10	11	12							
5													
6	18	17	16	15	14	13							
7													
8	19	20	21	22	23	24							
9													
10	30	29	28	27	26	25							
11													
12	31	32	33	34	35	36							
13													

I, GERALD W. CARLSON, in a field survey on Thursday, December 8, 1994, do hereby certify that under requirements of P.A. 74, Michigan P.A. of 1970, the corner points mentioned in lines 1 and 2 above were in conformance with regulations and rules therefore as required in the current manual of survey instructions of the United States Department of the Interior, Bureau of Land Management or by a decree of a Court of Law and/or that the corner points mentioned in lines 3, 4 and 5 above were in conformance with the rules of the Michigan Board of Land Surveyors or by a Decree of a Court of Law; established, re-established, monumented, re-monumented, recovered, found as expressed below:

**NOTE: Not more than 4 corners, all in the same town and range, may be recorded on this certificate.**

**A. Description of original monument and accessories and/or subsequent restoration:**

M-8: East 1/4 Corner of Section 24. 1844: William A. Burt's No date: MCRC drawing of county road construction plans original survey notes describe the corner monument as a wood post referenced by: indicate the corner at the P.I. in the county road with the distance north calculated at 2650.8 from centerline stationing.

12" Cedar N65E, 18 L      12" Birch N30W, 15 L

1988: Certificate of Survey recorded in Liber 001, Pg. 599 Van Neste distance North is 2650.80 and South is 2635.84'. by Glen C. Van Neste indicates the West 1/4 Corner of Section 19, T47N-R23W is a found 3/4" re-rod referenced by:

8" Maple Az 55,                      53.74'

3" Maple Az 104,                      49.82'

9" Maple Az 233,                      6.61'

**B. Description of corner evidence found and/or method applied in restoring or reestablishing corner:**

1994: Found and accepted the 3/4" iron as referenced in part A above. Iron is 14' west of centerline woods road to South and at approximate P.I. of county road. Distance North is 2650.80' and distance South is 2635.79.

**CERTIFIED BY PEER GROUP  
P.A. 345 OF 1990**

*Larry J. Bussan*  
DATE Oct 31, 1994

**C. Description of monument for corner and accessories established to perpetuate locating the position of the corner:**

1994 - Replaced 3/4" iron with a 2 1/2" diameter aluminum pipe capped with a 3 1/4" diameter tablet Marquette County Survey Monument stamped to identify the corner referenced by nails in:

8" Maple N55E 53.73 ft. GCVN NBT

3" Maple S76E 49.83 ft. GCVN NBT


9" Maple S57W 6.50 ft. GCVN NBT

10" Maple N21W 69.73 ft. (No blazes or BT tag)

Green steel sign post Duc West 1.0 ft.

Monument is set 0.3 ft. above ground.

Bk. 5, Pg. 103

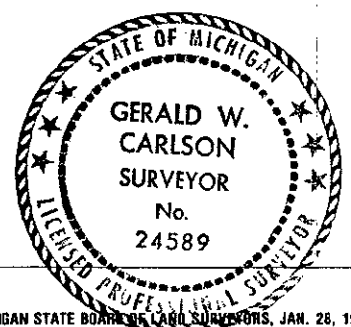

Signed by Gerald W. Carlson  
Surveyor's Michigan License No. 24589

Date 12-22-94