

SURVEY & REMONUMENTATION

MARQUETTE COUNTY
MICHIGAN
RECEIVED FOR RECORD

1994 DEC 28 PM 5:56

Patricia L. Monkeys
REGISTER OF DEEDS

LIBER **1** PAGE **153**
Register of Deeds Stamp & File Number

JOB NUMBER: 94030
SHEET NO. : 1-482

APR 28 1995

LAND CORNER RECORDATION CERTIFICATE

Filing Requirement of Act 74, Mich. P.A. 1970

For corners in

MARQUETTE
(County)

COMMISSION

Located In:

Corner Code ##

1. Public Land Survey	T <u>47N</u>	R <u>24W</u>	M-9	
	T _____	R _____		_____
	T _____	R _____		_____
	T _____	R _____		_____
	T _____	R _____		_____
2. Property Controlling in Section	S _____	T _____	R _____	_____
	S _____	T _____	R _____	_____
3. Miscellaneous Property in Sec.	S _____	T _____	R _____	_____
	S _____	T _____	R _____	_____

4. Lot No. _____, Recorded Plat _____
5. Private Claims _____

I, GERALD W. CARLSON, in a field survey on Tuesday, December 13, 1994, do hereby certify that under requirements of P.A. 74, Michigan P.A. of 1970, the corner points mentioned in lines 1 and 2 above were in conformance with regulations and rules therefore as required in the current manual of survey instructions of the United States Department of the Interior, Bureau of Land Management or by a decree of a Court of Law and/or that the corner points mentioned in lines 3, 4 and 5 above were in conformance with the rules of the Michigan Board of Land Surveyors or by a Decree of a Court of Law; established, re-established, monumented, re-monumented, recovered, found as expressed below:

NOTE: Not more than 4 corners, all in the same town and range, may be recorded on this certificate.

A. Description of original monument and accessories and/or subsequent restoration:

M-9: NE Corner of Section 25, 1844: William A. Burt's original survey notes describe the corner monument as a wood post referenced by:
 9" Sugar N67E, 10 L 14" Fir N46W, 13 L 11" Maple Az 34, 38.38' 3" Maple Az 143, 38.78'
 1852: A.D. Sullivan's original subdivision survey notes for T47N-R23W indicate the following additional references for the NE Corner of Section 25, T47N-R24W:
 15" Sugar S63E, 33 L 10" Sugar N71E, 10 L

1988: Certificate of Survey recorded in Liber 001, Pg. 599 by Glen C. Van Neste indicates the SW Corner of Section 19, T47N-R23W as a found 2" iron pipe referenced by:
 7" Maple Az 230, 22.72' 11" Maple Az 353, 38.92'
 1992: Land Corner Recordation Certificate recorded by Paul Bressette LLS No. 37270. Found a 2" iron pipe and witnesses as described in L. 1, Pg. 599, survey maps. (Record continued on reverse side).

B. Description of corner evidence found and/or method applied in restoring or reestablishing corner:

1994: Found and accepted DNR monument as referenced by Paul Bressette, P.S. No. 37270 in part A above. Distance North is 2635.79' and distance South is 2643.30'.

C. Description of monument for corner and accessories established to perpetuate locating the position of the corner:

1994 - Found a Department of Natural Resources iron pipe with 4" diameter aluminum cap in place referenced by nails in:
 10" Maple S44W 22.66 ft. Bressette NBT
 11" Maple N15W 38.80 ft. Bressette NBT
 12" Maple N31E 38.82 ft. Bressette NBT
 5" Maple S30E 39.02 ft. Bressette NBT
 Steel sign post South 1.0 ft.
 Monument is 1.0' East of a 5" diameter wood post. Stamped MCR 1994 on cap of monument (Marquette County Remonumentation).
 Bk. 5, Pg. 111


	A	B	C	D	E	F	G	H	I	J	K	L	M
2	6	5	4	3	2	1							
3													
4	7	8	9	10	11	12							
5													
6	18	17	16	15	14	13							
7													
8	19	20	21	22	23	24							
9													
10	30	29	28	27	26	25							
11													
12	31	32	33	34	35	36							
13													

**RATIFIED BY PEER GROUP
P.A. 345 OF 1990**

Larry J. Bassett
DATE Oct 31, 1994

Signed by Gerald W. Carlson
Surveyor's Michigan License No. 24589

Date 12-22-94

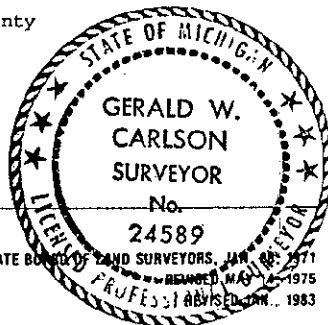

Record No. 482:

Part "A" Continued:

1992-Con't: Replaced found pipe with DNR monument and blazed upper and lower faces on NBTs. Measurements to notch in lower face. Referenced by:

10" Sugar	N45E,	38.25'
4" Sugar	S33E,	38.75'
8" Sugar	S49W,	22.4'
10" Sugar	N06W,	38.6'

L. 5 R.C., Pg. 358

*Revised
900
See Plan*