

**LAND CORNER RECORDATION CERTIFICATE**  
**Filing Requirement of Act 74, Mich. P.A. 1970 as Amended**

For corners in

Marquette	Located In:	Corner Code #
(County)		
1. Public Land Survey	T <u>48N</u> R <u>28W</u>	<u>A3</u>
	T _____ R _____	_____
	T _____ R _____	_____
	S _____ T _____	_____
2. Property Controlling in Section	S <u>18</u> T <u>48N</u> R <u>28W</u>	<u>12</u>
	S _____ T _____ R _____	_____
3. Miscellaneous Property in Sec.	S _____ T _____ R _____	_____
	S _____ T _____ R _____	_____

4. Lot No. \_\_\_\_\_, Recorded Plat \_\_\_\_\_  
 5. Private Claims

12 Jun 26 2007  
 A3 Jul 09 2007

I, Stephan J. Szyszkoski, in a field survey on \_\_\_\_\_, 20\_\_\_\_ do hereby state that under requirements of P.A. 74, Michigan P.A. of 1970, the corner points mentioned in lines 1 and 2 above were in conformance with regulations and rules therefore as required in the current manual of survey instructions of the United States Department of the Interior, Bureau of Land Management or by a decree of a Court of Law and /or that the corner points mentioned in lines 3, 4 and 5 above were in conformance with the rules of the Michigan Board of Land Surveyors or by a Decree of a Court of Law; established, re-established, monumented, recovered, found as expressed below:

**NOTE: Not more than 2 corners, all in the same town and range, may be recorded on this certificate.**

A. Description of original monument and accessories and/or subsequent restoration:

(A3) Corner common to Sections 6-7 T48N-R28W and Sections 1-12 T48N-R29W. 1846 - Established by Wm.A.Burt, Deputy Surveyor: Set Sugar post Cor. of Secs. 1 & 12. Fir 12 N11E 7 links, Y.Birch S54W 41 links. Oct. 1946 - Old notes at Marquette Co. Rd Commission state: Old post and new cedar post. Found no old BTs but new ones have been set by Ford Motor Co. July 1946. They are: Y.Birch 8" N2E 28.4 and Sugar 7" S31W 20.0'  
 (12-Sec. 18) South 1/16 corner, Section 18. Not established in the original survey.


B. Description of corner evidence found and/or method applied in restoring or reestablishing corner:

(A3) The original post and accessories were not recovered. Found a 3/4" ID iron pipe, projecting about 1.5 ft. above ground, set firm, at record bearing and distance from the Y.Birch NBT noted in the 1946 record, in good condition with many old scars. Also found Ford Motor Co. and Mead Corp location tags on nearby Sugar. Accepted the pipe as the best available evidence of the position of the original corner.  
 (12-Sec. 18) Established the corner midway and on a straight line between Quarter corner 1317.59' south and the intersection of Quarter lines 1317.59' north.

C. Description of monument for corner and accessories established to perpetuate locating the position of the corner:

(A3) Found 3/4" ID I.pipe. Set measuring nails in: 7" Sugar S60E 8.7' * mrkd "S7 NBT" 4" Sugar S28W 12.5' "S12 NBT" 4" Sugar N29W 15.0' "S1 NBT" Y.Birch (size not rec.) N5E 28.2' Treated 4x4 post adjacent. Bearings are magnetic. Distances are to nail with MDNR tag. * denotes tree with existing location tags.	(12) Set 1"IDx32" I.pipe with 4" alum. MDNR cap. Set measuring nails in: 4" Y.Birch N14E 14.15' mrkd "1/16S BT" 12" Sugar S88E 19.55' do 8" Spruce S19W 22.8' do 10" Sugar N36W 13.75' do 4x4 treated post adjacent. Bearings are magnetic. Distances are to nail with MDNR tag.
--	---

**Register of Deeds Stamp & File Number**

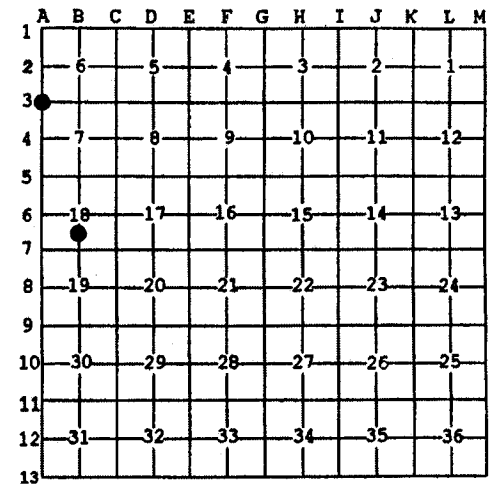

Signed by *Stephan J. Szyszkoski*  
 Surveyor's Michigan License No. 33986

Date 8/14/07

