LAND CORNER RECORDATION CERTIFICATE
Filing Requirement of Act 74, Mich. P.A. 1970 as Amended

For corners in

Marquette
(County)

	Located In:	Corner Code #
1. Public Land Survey	T 48N R 28W	A4
	T R	
	T R	
	S T R	
2. Property Controlling	S 18 T 48N R 28W	11
in Section	S T R	
3. Miscellaneous	S T R	
Property in Sec.	S T R	

Register of Deeds Stamp & File Number

4. Lot No. _____ , Recorded Plat_____

5. Private Claims

11 Jun 26 2007
A4 May 15 2007

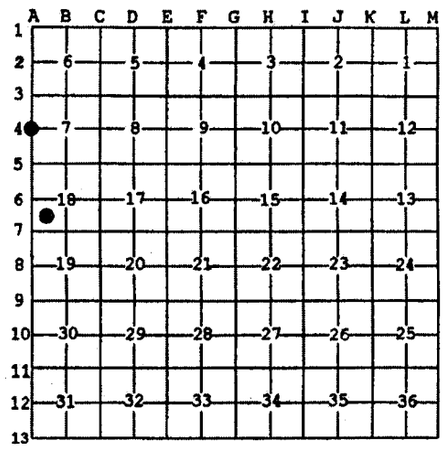

I, Stephan J. Szyszkoski, in a field survey on _____, 20 ____ do hereby state that under requirements of P.A. 74, Michigan P.A. of 1970, the corner points mentioned in lines 1 and 2 above were in conformance with regulations and rules therefore as required in the current manual of survey instructions of the United States Department of the Interior, Bureau of Land Management or by a decree of a Court of Law and /or that the corner points mentioned in lines 3, 4 and 5 above were in conformance with the rules of the Michigan Board of Land Surveyors or by a Decree of a Court of Law; established, re-established, monumented, recovered, found as expressed below:

NOTE: Not more than 2 corners, all in the same town and range, may be recorded on this certificate.

A. Description of original monument and accessories and/or subsequent restoration:

(A4) Quarter corner common to Section 7 T48N-R28W and Section 12 T48N-R29W. 1846 - Established by Wm.A.Burt, Deputy Surveyor. Set post midway and on line between Section corners 40.00 chains north and south. Sugar 14 N55E 12 links, Sugar 12 S71W 7 links. Found no subsequent record.
(11-Sec. 18) Southwest 1/16 corner, Section 18. Not established in the original survey.

B. Description of corner evidence found and/or method applied in restoring or reestablishing corner:

(A4) The original post and accessories were not recovered. Reestablished the corner using local control, at the intersection of old fence lines situated within rock rows running south and west from the corner position. The position for the corner is in substantial accord with the original record, being 4.65' west and 0.65' south of the proportionate position between section corners.
(11-Sec. 18) Established the corner at the intersection of straight lines connecting opposite 1/16 corners.

C. Description of monument for corner and accessories established to perpetuate locating the position of the corner:

(A4) Set 1"IDx32" I.pipe with 4" alum. MDNR cap. Set measuring nails in:
4" Sugar N61E 9.4' mrkd "1/4S NBT"
9" Y.Birch S60E 5.5' do
8" Maple N60W 15.75' do
6" dbl Sugar N06E 24.3' do
4x4 treated post adjacent. Bearings are magnetic. Distances are to nail with MDNR tag.

(11) Set 1"IDx32" I.pipe with 4" alum. MDNR cap. Set measuring nails in:
6" Maple N24E 6.0' mrkd "1/16S BT"
11" Cedar S85E 28.65' do
7" Maple S12E 9.9' do
5" Cedar N82W 32.6' do
Set sq'd cedar post adjacent. Bearings are magnetic. Distances are to nail with MDNR tag.

STATE OF MICHIGAN
STEPHAN J. SZYSZKOSKI
LAND SURVEYOR
No. 33986
LICENSED LAND SURVEYOR

Signed by Stephen J. Szyszkoski Date 8/14/07

Surveyor's Michigan License No. 33986

For the Michigan Department of Natural Resources, Office of Land and Facilities

FORM APPROVED BY MICHIGAN STATE BOARD OF PROFESSIONAL SURVEYORS, JAN. 28, 1971
Revised May 14, 1975
Revised Jan., 1983
Rervised Oct., 1995