

LAND CORNER RECORDATION CERTIFICATE
Filing Requirement of Act 74, Mich. P.A. 1970 as Amended

For corners in

| | | |
|---------------------------------------|---------------------------|---------------|
| <u>Marquette</u> (County) | Located In: | Corner Code # |
| 1. Public Land Survey | T <u>48N</u> R <u>28W</u> | <u>A6</u> |
| | T <u>48N</u> R <u>28W</u> | <u>A5</u> |
| | T _____ R _____ | _____ |
| 2. Property Controlling in Section | S _____ T _____ R _____ | _____ |
| | S _____ T _____ R _____ | _____ |
| 3. Miscellaneous Property in Sec. | S _____ T _____ R _____ | _____ |
| | S _____ T _____ R _____ | _____ |
| 4. Lot No. _____, Recorded Plat _____ | | |
| 5. Private Claims | | |

Register of Deeds Stamp & File Number

| | | | | | | | | | | | | | |
|----|----|---|----|---|----|---|----|---|----|---|----|---|---|
| | A | B | C | D | E | F | G | H | I | J | K | L | M |
| 1 | | | | | | | | | | | | | |
| 2 | 6 | | 5 | | 4 | | 3 | | 2 | | 1 | | |
| 3 | | | | | | | | | | | | | |
| 4 | 7 | | 8 | | 9 | | 10 | | 11 | | 12 | | |
| 5 | | | | | | | | | | | | | |
| 6 | 18 | | 17 | | 16 | | 15 | | 14 | | 13 | | |
| 7 | | | | | | | | | | | | | |
| 8 | 19 | | 20 | | 21 | | 22 | | 23 | | 24 | | |
| 9 | | | | | | | | | | | | | |
| 10 | 30 | | 29 | | 28 | | 27 | | 26 | | 25 | | |
| 11 | | | | | | | | | | | | | |
| 12 | 31 | | 32 | | 33 | | 34 | | 35 | | 36 | | |
| 13 | | | | | | | | | | | | | |

Jun 27 2007

I, Stephan J. Szyszkoski, in a field survey on _____, 20____ do hereby state that under requirements of P.A. 74, Michigan P.A. of 1970, the corner points mentioned in lines 1 and 2 above were in conformance with regulations and rules therefore as required in the current manual of survey instructions of the United States Department of the Interior, Bureau of Land Management or by a decree of a Court of Law and /or that the corner points mentioned in lines 3, 4 and 5 above were in conformance with the rules of the Michigan Board of Land Surveyors or by a Decree of a Court of Law; established, re-established, monumented, recovered, found as expressed below:

NOTE: Not more than 2 corners, all in the same town and range, may be recorded on this certificate.

A. Description of original monument and accessories and/or subsequent restoration:


- (A6) Quarter corner common to Section 18 T48N-R28W and Section 13 T48N-R29W. 1846 - Established by Wm.A.Burt, Deputy Surveyor: Set sugar post midway and on line between Section corners 40.00 chains north and south. W.Birch 10 N24E 25 links, W.Birch 6 S23W 37 links.
 (A5) Corner common to Sections 7-18 T48N-R28W and Sections 12-13 T48N-R29W. 1846 - Established by Wm.A.Burt, Deputy Surveyor: Set cedar post, Fir 12 N15E 6 links, Cedar 10 S67W 6 links.

B. Description of corner evidence found and/or method applied in restoring or reestablishing corner:

- (A6) The original post and accessories were not recovered. Found no evidence of the position of the original corner on the ground. Reestablished the corner midway and on the Range line between Section corners 2631.23' north and south, being proportionate to the original record.
 (A5) The original post and accessories were not recovered. Found no evidence of the position of the original corner on the ground. Reestablished the corner by single proportionate measurement to the original record, on the Range line between Section corner 10524.93' South and Quarter corner 2631.23' North.

C. Description of monument for corner and accessories established to perpetuate locating the position of the

- | | |
|--|--|
| (A6) Set 1"IDx32" I.pipe with 4" alum. MDNR cap. Set measuring nails in: 5" Maple N30E 10.05' mrkd "1/4S NBT" 5" Sugar S58E 6.95' do 6" Maple S64W 25.65' do 5" Maple N33W 14.2' do set sq'd cedar post adjacent. Bearings are magnetic. Distances are to nail with MDNR tag. | (A5) Set 1"IDx32" I.pipe with 4" alum. MDNR cap. Set measuring nails in: 4" Maple N07W 6.7' mrkd "S12 NBT" 8" dbl Maple N81E 41.25' "S7 NBT" 6" Maple S30W 14.3' "S13 NBT" 6" Spruce N88W 24.0' "S12 NBT" Sq'd a 6" Balsam N48E 1.4' to center. Bearings are magnetic. Distances are to nail with MDNR tag. |
|--|--|

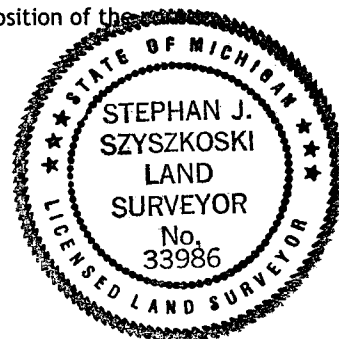

Signed by Stephan J. Szyszkoski
 Surveyor's Michigan License No. 33986

Date 8/14/07

For the Michigan Department of Natural Resources, Office of Land and Facilities