

LAND CORNER RECORDATION CERTIFICATE
Filing Requirement of Act 74, Mich. P.A. 1970 as Amended

For corners in

<u>Marquette</u> (County)	Located In:	Corner Code #
1. Public Land Survey	T <u>48N</u> R <u>28W</u>	<u>A8</u>
	T <u>48N</u> R <u>28W</u>	<u>C5</u>
	T _____ R _____	_____
2. Property Controlling in Section	S _____ T _____ R _____	_____
	S _____ T _____ R _____	_____
3. Miscellaneous Property in Sec.	S _____ T _____ R _____	_____
	S _____ T _____ R _____	_____
4. Lot No. _____, Recorded Plat _____		
5. Private Claims		

Register of Deeds Stamp & File Number

A	B	C	D	E	F	G	H	I	J	K	L	M
1												
2	6		5		4		3		2		1	
3												
4	7		8		9		10		11		12	
5												
6	18		17		16		15		14		13	
7												
8	19		20		21		22		23		24	
9												
10	30		29		28		27		26		25	
11												
12	31		32		33		34		35		36	
13												

Jul 02 2007

I, Stephan J. Szyszkoski, in a field survey on _____, 20____ do hereby state that under requirements of P.A. 74, Michigan P.A. of 1970, the corner points mentioned in lines 1 and 2 above were in conformance with regulations and rules therefore as required in the current manual of survey instructions of the United States Department of the Interior, Bureau of Land Management or by a decree of a Court of Law and /or that the corner points mentioned in lines 3, 4 and 5 above were in conformance with the rules of the Michigan Board of Land Surveyors or by a Decree of a Court of Law; established, re-established, monumented, recovered, found as expressed below:

NOTE: Not more than 2 corners, all in the same town and range, may be recorded on this certificate.

A. Description of original monument and accessories and/or subsequent restoration:


- (A8) Quarter corner common to Section 19 T48N-R28W and Section 24 T48N-R29W. 1846 - Established by Wm.A.Burt, Deputy Surveyor: Set Fir post midway between Section corners 40.00 chains north and south. W.Birch 10 N24E 25 links, W.Birch 6 S23W 37 links.
- (C5) Corner common to Sections 7-8-17-18. 1849 - Established by Wells Burt; Deputy Surveyor: Set Sugar post. Hemlock 18 S52W 54 links, Sugar 14 N21E 52 links.

B. Description of corner evidence found and/or method applied in restoring or reestablishing corner:

- (A8) The original post and accessories were not recovered. Found no evidence of the position of the original corner on the ground. Reestablished the corner on the Range line between Section corner 2631.23' south and Quarter corner 10524.92' north, being proportionate to the original record.
- (C5) The original post and accessories were not recovered. Found no evidence of the position of the original corner on the ground. Reestablished the corner by double proportionate measurement to the original record between Section corner 5283.27' north (5280' GLO), Quarter corner 7924.89' south (7920' GLO), Quarter corner 2628.95' west (2640' GLO), and Section corner 5236.91' east (5258.9' GLO).

C. Description of monument for corner and accessories established to perpetuate locating the position of the corner:

- | | |
|---|---|
| (A8) Set 1"IDx32" I.pipe with 4" alum.
MDNR cap. Set measuring nails in: | (C5) Set 1"IDx32" I.pipe with 4" alum.
MDNR cap. Set measuring nails in: |
| 6" Sugar N87E 32.4' mrkd "1/4S NBT" | 8" Maple N55E 20.0' mrkd "S8 NBT" |
| 5" Maple S31E 22.1' do | 9" Sugar S21E 15.8' "S17 NBT" |
| 8" Cedar S30W 49.8' do | 5" Sugar S79W 5.3' "S18 NBT" |
| 8" Spruce N62W 34.1' do | 5" Sugar N63W 24.3' "S7 NBT" |
| Set sq'd Cedar post adjacent. Bearings are magnetic. Distances are to nail with MDNR tag. | Set sq'd cedar post adjacent. Bearings are magnetic. Distances are to nail with MDNR tag. |

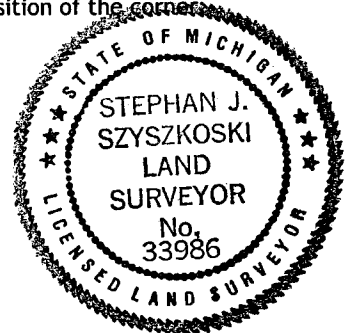

Signed by Stephan J. Szyszkoski
 Surveyor's Michigan License No. 33986

Date 8/14/07

For the Michigan Department of Natural Resources, Office of Land and Facilities