

LAND CORNER RECORDATION CERTIFICATE
Filing Requirement of Act 74, Mich. P.A. 1970 as Amended

For corners in

<u>Marquette</u> (County)	Located In:	Corner Code #
1. Public Land Survey	T48N R 28W	A9
	T48N R 28W	J7
	T _____ R _____	_____
2. Property Controlling in Section	S _____ T _____ R _____	_____
	S _____ T _____ R _____	_____
3. Miscellaneous Property in Sec.	S _____ T _____ R _____	_____
4. Lot No. _____, Recorded Plat _____		
5. Private Claims		

Register of Deeds Stamp & File
Number

A	B	C	D	E	F	G	H	I	J	K	L	M
1												
2	6	5	4	3	2	1						
3												
4	7	8	9	10	11	12						
5												
6	18	17	16	15	14	13						
7									●			
8	19	20	21	22	23	24						
9	●											
10	30	29	28	27	26	25						
11												
12	31	32	33	34	35	36						
13												

J7 Jul 16 2007
A9 Oct 16 2007


I, Stephan J. Szyszkoski, in a field survey on _____, 20__ do hereby state that under requirements of P.A. 74, Michigan P.A. of 1970, the corner points mentioned in lines 1 and 2 above were in conformance with regulations and rules therefore as required in the current manual of survey instructions of the United States Department of the Interior, Bureau of Land Management or by a decree of a Court of Law and /or that the corner points mentioned in lines 3, 4 and 5 above were in conformance with the rules of the Michigan Board of Land Surveyors or by a Decree of a Court of Law; established, re-established, monumented, recovered, found as expressed below:

NOTE: Not more than 2 corners, all in the same town and range, may be recorded on this certificate.

A. Description of original monument and accessories and/or subsequent restoration:
(A9) Corner common to Sections 19-30 T48N-R28W and Sections 24-25 T48N-R29W. 1846 - Established by Wm. A. Burt, Deputy Surveyor: Set maple post. W.Birch 10 N68E 26 links, W.Birch 10 S16W 8 links. Old notes from Marquette Co. Rd. Commission, ca. 1946 state Iron pipe and cairn of stones (FB 601 PP 144 & 145).
(J7) Quarter corner common to Sections 14 and 23. 1848 - Established by Wells Burt, Deputy Surveyor: Set Sugar post midway and on the Section line between Section corners 40.13 chains east and west. Sugar 12 N29E 44 links, Sugar 9 S58W 43 links. 2007 - Information from Robert Spear RLS indicates that the corner position is monumented with an iron pipe and that this position has been used by him and others to subdivide Section 23.

B. Description of corner evidence found and/or method applied in restoring or reestablishing corner:
(A9) Fd. a 3/4" ID Iron pipe in a small mound of rock (1'x1') with 3 existing trees marked by persons unknown for witnesses: 8" Maple N58E in good condition with untagged measuring nail visible, 10" Maple S59W in good condition, and 8" Maple N01E, now dead. Accepted the pipe as the best available evidence of the position of the original corner. Made new witnesses as described below.
(J7) The original post and accessories were not recovered. Found a 1.5" OD I.pipe, set firm, projecting about 2.5 ft. above ground and accepted same as the best available evidence of the position of the original corner. BH blazes were found on 4 nearby trees. The position of the monument checks with measurements furnished by Robert Spear PS, to nearby corners. Accepted the monument as a careful and faithful perpetuation of the position of the original corner.

C. Description of monument for corner and accessories established to perpetuate locating the position of the corner:
(A9) Found 3/4" ID I.pipe in rock mound. Set measuring nail with MDNR tag in the side of:
8" Maple N58E 28.2' marked "S19 NBT" (old wit. tree)
10" Maple S59W 12.7' mrkd "S25 NBT" do
8" Balsam N48E 4.8' mrkd "S19 NBT"
7" Sugar N07W 28.4' mrkd "S30 NBT"
Bearings are magnetic.
(J7) Found 1.5" O.D. iron pipe. Set measuring nail with MDNR tag in the side of the following:
4" W.Pine N88E 11.0' marked by others
6" W.Pine S27E 18.4' do
Found meas. nails in the side of the following:
22" Maple S79W 18.2' old BH blaze
8" Spruce N11W 5.65' old blaze/loc. tag
Bearings are magnetic.

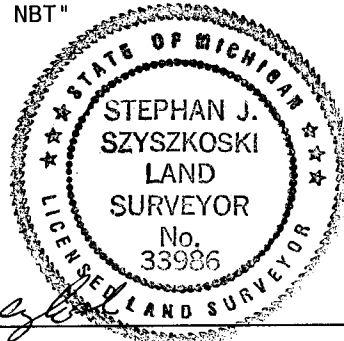

Signed by Stephan J. Szyszkoski Date 11-7-07

Surveyor's Michigan License No. 33986