

LAND CORNER RECORDATION CERTIFICATE
Filing Requirement of Act 74, Mich. P.A. 1970 as Amended

For corners in

<u>Marquette</u> (County)	Located In:	Corner Code #
1. Public Land Survey	T <u>48N</u> R <u>28W</u>	<u>B7</u>
	T _____ R _____	_____
	T _____ R _____	_____
2. Property Controlling in Section	S <u>18</u> T <u>48N</u> R <u>28W</u>	<u>8</u>
	S _____ T _____ R _____	_____
	S _____ T _____ R _____	_____
3. Miscellaneous Property in Sec.	S _____ T _____ R _____	_____
	S _____ T _____ R _____	_____
4. Lot No. _____, Recorded Plat _____		
5. Private Claims		

Register of Deeds Stamp & File
Number

1	A	B	C	D	E	F	G	H	I	J	K	L	M
2		6		5		4		3		2		1	
3													
4		7		8		9		10		11		12	
5													
6		● 18		17		16		15		14		13	
7		●											
8		19		20		21		22		23		24	
9													
10		30		29		28		27		26		25	
11													
12		31		32		33		34		35		36	
13													

I, Stephan J. Szyszkoski, in a field survey on July 9, 2007 do hereby state that under requirements of P.A. 74, Michigan P.A. of 1970, the corner points mentioned in lines 1 and 2 above were in conformance with regulations and rules therefore as required in the current manual of survey instructions of the United States Department of the Interior, Bureau of Land Management or by a decree of a Court of Law and /or that the corner points mentioned in lines 3, 4 and 5 above were in conformance with the rules of the Michigan Board of Land Surveyors or by a Decree of a Court of Law; established, re-established, monumented, recovered, found as expressed below:

NOTE: Not more than 2 corners, all in the same town and range, may be recorded on this certificate.

A. Description of original monument and accessories and/or subsequent restoration:

(B7) Quarter corner common to Sections 18-19. 1848 - Established by Wells Burt, Deputy Surveyor: Set Y.Birch post on the Section line between Section corner 40.00 chains east and Section corner 40.34 chains west. ca. 1946 - Notes at Marquette Co. Rd. Commission state "Old B.T.'s Set iron pin. New B.T.'s Balsam 12" N33W 18.5, Balsam 6" S17W 36.1'. 1979 - A.O.Enger RLS recovered a 1"o.d. iron pipe with mushroomed top and two dead Balsam NBTs: 9" S27W 36.4', and 15" N32W 18.3', as well as what he thought were the remains of the OBT Y.Birch S51W 11.8', badly rotted. Mr. Enger made new witnesses: Cedar 10" N46W 50.6', and Cedar 8" N62E 57.2'.

(8-Sec. 18) West 1/16 corner, Section 18. Not established in the original survey.

B. Description of corner evidence found and/or method applied in restoring or reestablishing corner:


(B7) The original post and accessories were not recovered. Found a 3/4" ID iron pipe projecting 2.3' above ground with "mushroomed" top at approximate record bearing and distance from what appears to be the remains of the 1946 NW NBT Balsam, now a dead and rotting stump with no marks visible. Found the 1979 Cedar NBTs by Mr. Enger in good condition and at record bearing and distance. Accepted the pipe as a careful and faithful perpetuation of the position of the original corner.

(8-Sec. 18) Established the corner on a straight line between Quarter corner 1368.48' west and the intersection of 1/4 lines of Section 18 1338.37' east, being proportionate to the dimensions given on the original plat of this township (20 chains west of the Center of Section 18).

C. Description of monument for corner and accessories established to perpetuate locating the position of the corner:

(B7) Fd. 3/4" ID I.pipe. Drove to 1 ft. above ground.	(8) Set 1"IDx32" I.pipe with 4" alum. MDNR cap
Set measuring nail with MDNR tag in the side of:	made firm in a mound of rock. Set measuring nail
7" Maple N32E 15.1' mrkd "1/4S NBT"	with MDNR tag in the side of:
5" dbl Y.Birch N8E 16.7' do	11" Oak N40E 33.9' mrkd "1/16S BT"
6" Ash S81E 10.3' do	11" Oak S50E 13.4' do
5" Ash S85W 6.8' do	6" Oak S23W 29.1' do
9" Cedar N68E 57.6' scribing visible (1979 NBT)	4" W.Pine S80W 11.6' do
11" Cedar N42W 51.4' blazes overgrown do	treated 4x4 post adjacent. Brgs are magnetic.
Brgs are magnetic.	

Signed by Stephan J. Szyszkoski Date 11/7/07

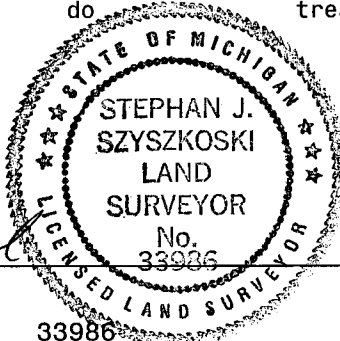

Surveyor's Michigan License No. 33986