LAND CORNER RECORDATION CERTIFICATE
Filing Requirement of Act 74, Mich. P.A. 1970 as Amended

For corners in

Marquette (County)

	Located In:			Corner Code #
1. Public Land Survey		T 48N	R 28W	C7
		T	R	
		T	R	
	S	T	R	
2. Property Controlling	S 18	T 48N	R 28W	1
in Section	S	T	R	
3. Miscellaneous	S	T	R	
Property in Sec.	S	T	R	

Register of Deeds Stamp & File Number

4. Lot No. _____ , Recorded Plat_____

5. Private Claims

1 Jul 09 2007
C7 Jul 03 2007

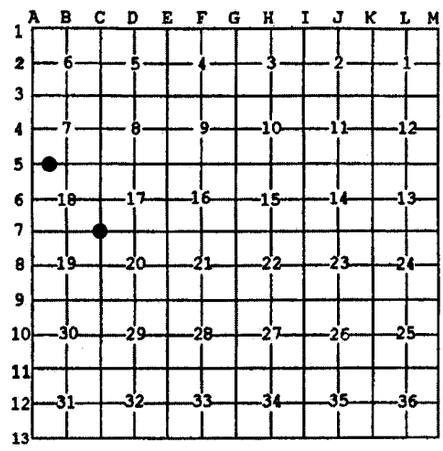

I, Stephan J. Szyszkoski, in a field survey on _____, 20 ____ do hereby state that under requirements of P.A. 74, Michigan P.A. of 1970, the corner points mentioned in lines 1 and 2 above were in conformance with regulations and rules therefore as required in the current manual of survey instructions of the United States Department of the Interior, Bureau of Land Management or by a decree of a Court of Law and /or that the corner points mentioned in lines 3, 4 and 5 above were in conformance with the rules of the Michigan Board of Land Surveyors or by a Decree of a Court of Law; established, re-established, monumented, recovered, found as expressed below:

NOTE: Not more than 2 corners, all in the same town and range, may be recorded on this certificate.

A. Description of original monument and accessories and/or subsequent restoration:

(C7) Corner common to Sections 17-18-19-20. 1849 - Established by Wells Burt, Deputy Surveyor: Set sugar post. Y.Birch 30 S74W 14 links, Sugar 7 S79E 36. 1946 - Survey notes of Marquette Co. Rd. Commission state: "Old post - Oct. 2, 1946".
(1-Sec. 18) West 1/16 corner between Sections 7 and 18. Not monumented in the original survey. The original GLO plat for this township gives distances of 20.00 chains east to Quarter corner and 20.56' chains west to Section corner.

B. Description of corner evidence found and/or method applied in restoring or reestablishing corner:

(C7) The original post and accessories were not recovered. Found remains of old fence lines south and west and traced them to an approximate intersection S69E 20' from the position subsequently monumented. The fence posts are all down and very little is left. Due to the unmaintained and neglected character of the fence, and the fact that its location does not harmonize in any way with the record measurements to adjacent corners, I do not accept it as the best available evidence of the position of the original corner. Found no other evidence on the ground. Reestablished the corner by double proportionate measurement to the original record between Quarter corner 2644.55' west (2640' GLO), Quarter corner 2626.66' east (2622.18' GLO), Quarter corner 2641.63' south (2640' GLO), and Section corner 10566.53' north (10560' GLO).
(1-Sec. 18) Established the corner on the Section line between Quarter corner 1340.47' east and Section corner 1378.00' west, being proportionate to the original record.

C. Description of monument for corner and accessories established to perpetuate locating the position of the corner:

(C7) Set 1"IDx32" I.pipe with 4" alum. MDNR cap. Set measuring nails in:
7" Y.Birch N47E 13.0' mrkd "S17 NBT"
4" Sugar S83E 7.0' "S20 NBT"
6" Sugar S58W 27.0' "S19 NBT"
6" Maple N27W 14.6' "S18 NBT"
Set sq'd Cedar post adjacent. Bearings are magnetic. Distances are to nail with MDNR tag.

(1) Set 1"IDx32" I.pipe with 4" alum. MDNR cap. Set measuring nails in:
17" Y.Birch N71E 16.9' mrkd "1/16S BT"
14" Cedar S50E 43.5' do
8" Hemlock S06W 18.1' do
4" Maple N52W 11.0' do
treated 4x4 post adjacent. Bearings are magnetic. Distances are to nail with MDNR tag.

STATE OF MICHIGAN
STEPHAN J. SZYSZKOSKI
LAND SURVEYOR
No. 33986
LICENSED LAND SURVEYOR

Signed by Stephan J. Szyszkoski Date 8/14/07

Surveyor's Michigan License No. 33986

For the Michigan Department of Natural Resources, Office of Land and Facilities

FORM APPROVED BY MICHIGAN STATE BOARD OF PROFESSIONAL SURVEYORS, JAN. 28, 1971
Revised May 14, 1975
Revised Jan., 1983
Revised Oct., 1995