

# SURVEY & REMONUMENTATION

MAY 22 1997

COMMISSION

## LAND CORNER RECORDATION CERTIFICATE Filing Requirement of Act 74, Mich. P.A. 1970

For corners in


MARQUETTE

(County)

Located In:

Corner Code #

- |                                    |                   |        |
|------------------------------------|-------------------|--------|
| 1. Public Land Survey              | T 48NR 30W        | L-13 ✓ |
|                                    | T 47NR 30W        | L-1    |
|                                    | T ___ R ___       | _____  |
|                                    | T ___ R ___       | _____  |
| 2. Property Controlling in Section | S ___ T ___ R ___ | _____  |
|                                    | S ___ T ___ R ___ | _____  |
| 3. Miscellaneous Property in Sec.  | S ___ T ___ R ___ | _____  |
|                                    | S ___ T ___ R ___ | _____  |

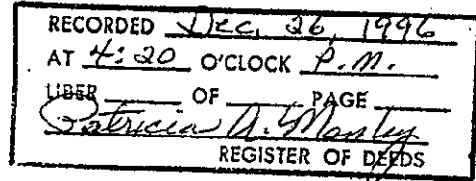

LIBER **1** PAGE **384**  
Register of Deeds Stamp & File Number

4. Lot No. \_\_\_\_\_, Recorded Plat \_\_\_\_\_  
5. Private Claims \_\_\_\_\_

I, ALAN K. PIERCE, in a field survey on NOVEMBER, 19 96 do hereby state that under requirements of P.A. 74, Michigan P.A. of 1970, the corner points mentioned in lines 1 and 2 above were in conformance with regulations and rules therefore as required in the current manual of survey instructions of the United States Department of the Interior, Bureau of Land Management or by a decree of a Court of Law and for that the corner points mentioned in lines 3, 4 and 5 above were in conformance with the rules of the Michigan Board of Land Surveyors or by a Decree of a Court of Law; established, re-established, monumented, recovered, found as expressed below:

NOTE: Not more than 2 corners, all in the same town and range, may be recorded on this certificate.

A	B	C	D	E	F	G	H	I	J	K	L
1											
2	6		5		4		3		2		1
3											
4	7		8		9		10		11		12
5											
6	10		17		16		15		14		13
7											
8	19		20		21		22		23		24
9											
10	30		29		28		27		26		25
11											
12	31		32		33		34		35		36
13											

**A. Description of original monument and accessories and/or subsequent restoration:**

Quarter Corner common to Sections 1 and 36, T47/48N - R30W

L-13: 1846; W. A. John and Austin Burt D. S. set a Yellow Birch post witnessed by: 10" Fir N34.5°E 43L; 9" Sugar Maple N54°W 15L. 1904; Under special instructions from the G.L.O. Commissioner dated March 17, 1904 and prior to starting a "Survey of fifteen (15) islands in Lake Michigan", Arthur Kidder D. S. found a 3" X 3" Cedar post 2' above grade and a strip of wagon tire 2' above grade. No witnesses noted. 1947; M.C.R.C. Book No. 530 shows an iron pin and an iron sleigh runner witnessed by: 7" Maple S66°W 29.2'; 6" Sugar Maple N63°E 23.4'. 1982; R.L.S. No. 25836 recovered a 1-3/4" pin with scribed Maple NE and scribed stump SW and established the following witnesses with P.K. nails in: 6" Maple N60°E 23.58'; 10" Maple S70°W 30.35'; 6" Balsam S15°W 18.81'; 12" Maple N10°W 23.05'. Recorded in L4R.C., Pg. 200.

**B. Description of corner evidence found and/or method applied in restoring or reestablishing corner:**

**RATIFIED BY PEER GROUP  
P.A. 345 OF 1990**

Larry J. Busome  
DATE 11/4/96

L-13: 1996; ECI recovered 1-3/4" iron pin adjacent to 1-1/2" wide sleigh runner (wagon wheel strip). No original evidence recovered. The following measurements were taken to Kidder Island Survey (K.G.L.O.) terrain calls: East "leave swamp" ECI 254' - K.G.L.O. 244', "enter swamp" ECI 924' - K.G.L.O. 914', "top of slope" K.G.L.O. 1970' (call indistinct); West "top of brushy slope" ECI 410' -K.G.L.O. 405', "ascend granite ridge" K.G.L.O. 2253' (call indistinct), "top of granite ridge" ECI 2390' -K.G.L.O. 2385'. Corner position established by acceptance of found iron pin as a careful and faithful reestablishment of the position of the original corner. Distance East is 2630.44' and distance West is 2644.76'.

**C. Description of monument for corner and accessories established to perpetuate locating the position of the corner:**

1996: Replaced 1-3/4" pin and 1-1/2" wide sleigh runner with a 2-3/8" O.D. aluminum pipe capped with a 3-1/4" aluminum tablet. Marquette County Survey monument stamped to identify the corner set about 0.6' above grade. Bearing trees are face, nail & butt blazed and painted yellow with B.T. tags attached. Butt blaze is scribed "B.T.". Three 1982 trees were utilized with distances measured from a duplex nail with an orange washer stamped "ECI 30097" in the side of the tree. Bearings are magnetic.

14" Triple Maple S88°E 8.81' (N.B.T.); 8" Balsam S17°W 18.74'; 14" Maple S81°W 30.30'; 18" Twin Maple N08°W 23.18'  
Steel fence post with survey marker sign - North 1.0'.

Signed by Alan K. Pierce  
Surveyor's Michigan License No. 30097

Date 12-19-96

