

1993

COMMISSION

JOB NUMBER: 93300
SHEET NO. : 1-338
For corners in

LAND CORNER RECORDATION CERTIFICATE
Filing Requirement of Act 74, Mich. P.A. 1970

MARQUETTE COUNTY
MICHIGAN
RECEIVED FOR RECORD
1993 DEC 22 PM 4:13
REGISTERED SURVEYOR

Located In: MARQUETTE (County)

Corner Code # A-6 ✓

1. Public Land Survey	T48N R25W	<u>A-6</u>
	T48N R26W	<u>M-6</u>
	T _____ R _____	_____
	T _____ R _____	_____
2. Property Controlling in Section	S _____ T _____ R _____	_____
	S _____ T _____ R _____	_____
3. Miscellaneous Property in Sec.	S _____ T _____ R _____	_____
	S _____ T _____ R _____	_____
4. Lot No. _____, Recorded Plat _____		
5. Private Claims _____		

Liber 1 R.C., Page 12
Register of Deeds Stamp & File Number

I, GERALD W. CARLSON, in a field survey on Saturday, December 4, 1993, do hereby certify that under requirements of P.A. 74, Michigan P.A. of 1970, the corner points mentioned in lines 1 and 2 above were in conformance with regulations and rules therefore as required in the current manual of survey instructions of the United States Department of the Interior, Bureau of Land Management or by a decree of a Court of Law and/or that the corner points mentioned in lines 3, 4 and 5 above were in conformance with the rules of the Michigan Board of Land Surveyors or by a Decree of a Court of Law; established, re-established, monumented, re-monumented, recovered, found as expressed below:

A	B	C	D	E	F	G	H	I	J	K	L	M
2	6	5	4	3	2	1						
3												
4	7	8	9	10	11	12						
5												
6	18	17	16	15	14	13						
7												
8	19	20	21	22	23	24						
9												
10	30	29	28	27	26	25						
11												
12	31	32	33	34	35	36						
13												

NOTE: Not more than 4 corners, all in the same town and range, may be recorded on this certificate.

A. Description of original monument and accessories and/or subsequent restoration:


A-6: Quarter Corner common to Section 18, T48N-R25W and Section 13, T48N-R26W. 1845: William A. Burt's original survey notes describe the corner monument as a wood post referenced by:
5" Spruce S57W 17 l
12" Cedar N23W, 21 l

B. Description of corner evidence found and/or method applied in restoring or reestablishing corner:

1993 - No original evidence of B.T.'s was found at corner location. G.L.O. line calls can't substantiate placement. This corner was set on a proportion between the West 1/4 corner of Section 19 of the NW corner of Section 18. Using the proportioned position, the South 1/4 corner of Section 19 has only a 2 minute deflection on the South line of Section 18 to the pro rated corner. G.L.O. calls on the West line of Section 18 to pro rated corner check well, the general bearing of the range line checks well, G.L.O. tie to the Dead River North of the SW corner of Section 18 fits within 7 feet. Peer group ratification 11-29-93.

C. Description of monument for corner and accessories established to perpetuate locating the position of the corner:

1993 - Set a 2 1/8" diameter aluminum pipe capped with a 3/4" diameter aluminum tablet, Marquette County Survey Monument stamped to identify corner referenced by nails in:
11" Maple S38W 77.98 ft.
13" Cedar N49W 60.39 ft.
15" Maple N76E 125.28 ft.
10" Maple S71E 126.83 ft.
Corner is 0.63' above ground.

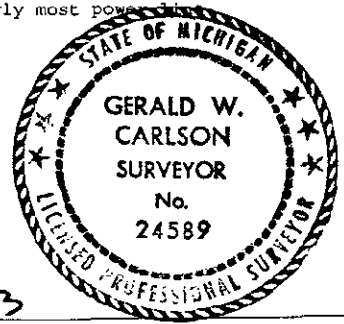

Signed by Gerald W. Carlson Date 12-22-93
Surveyor's Michigan License No. 24589