

JOB NUMBER: 93300  
 SHEET NO. : 1-342  
 For corners in

**LAND CORNER RECORDATION CERTIFICATE**  
**Filing Requirement of Act 74, Mich. P.A. 1970**

MARQUETTE COUNTY  
 MICHIGAN  
 RECEIVED FOR RECORDATION  
 1993 DEC 22 PM 4:14  
 REGISTERED PROFESSIONAL SURVEYOR  
 78  
 Liber J.R.C., Page 14  
 Register of Deeds Stamp & File Number

Located In: MARQUETTE (County) Corner Code A-10

1. Public Land Survey	T <u>48N</u> R <u>25W</u>	<u>A-10</u>
	T <u>48N</u> R <u>26W</u>	<u>M-10</u>
	T _____ R _____	_____
	T _____ R _____	_____
2. Property Controlling in Section	S _____ T _____ R _____	_____
	S _____ T _____ R _____	_____
3. Miscellaneous Property in Sec.	S _____ T _____ R _____	_____
	S _____ T _____ R _____	_____

4. Lot No. \_\_\_\_\_, Recorded Plat \_\_\_\_\_  
 5. Private Claims \_\_\_\_\_

I, GERALD W. CARLSON, in a field survey on Tuesday, December 7, 1993, do hereby certify that under requirements of P.A. 74, Michigan P.A. of 1970, the corner points mentioned in lines 1 and 2 above were in conformance with regulations and rules therefore as required in the current manual of survey instructions of the United States Department of the Interior, Bureau of Land Management or by a decree of a Court of Law and/or that the corner points mentioned in lines 3, 4 and 5 above were in conformance with the rules of the Michigan Board of Land Surveyors or by a Decree of a Court of Law; established, re-established, monumented, re-monumented, recovered, found as expressed below:

**NOTE: Not more than 4 corners, all in the same town and range, may be recorded on this certificate.**

	A	B	C	D	E	F	G	H	I	J	K	L	M
2	6	5	4	3	2								
3													
4	7	8	9	10	11	12							
5													
6	18	17	16	15	14	13							
7													
8	19	20	21	22	23	24							
9													
10	30	29	28	27	26	25							
11													
12	31	32	33	34	35	36							
13													

**A. Description of original monument and accessories and/or subsequent restoration:**

A-10: Quarter Corner common to Section 30, T48N-R25W and Section 25, T48N-R26W. 1845: William A. Burt's original survey notes describe the corner monument as a wood post referenced by:  
 14" Hemlock S50W, 19 1  
 6" Hemlock N24W, 20 1


1940 - Marquette County Road Commission field book #698 indicates a corner as a Cedar post referenced by:  
 10" Oak N47W 15.3 ft.  
 6" Spruce S48E 16.0 ft.  
 With coordinates S2699.38, E2634.94.

**B. Description of corner evidence found and/or method applied in restoring or reestablishing corner:**

1993 - Found 1 1/2" pipe and 1/2" iron. Corner position checks with Marquette County Road Commission survey of Section 25 in the 1940's. Checks with Cleveland Cliffs Iron Company distance to the SW corner of Section 30, within 0.05 ft. Checks to the 1940 Marquette County Road Commission distance 10.4 ft. short. The angle at the West 1/4 corner of Section 30 checks within 00 11' min. of the 1940 Marquette County Road Commission survey indicating that there was a bend in the line at that time. Replaced the 1 1/2" pipe and 1/2" iron with Marquette County Survey Monument. Peer group ratification 11-29-93.

**C. Description of monument for corner and accessories established to perpetuate locating the position of the corner:**

1993 - Replaced 1/2" iron and 1 1/2" pipe with a 2 1/8" diameter aluminum pipe capped with a 3 1/4" diameter aluminum tablet Marquette County Survey Monument stamped to identify the corner referenced by nails in:  
 7" Maple N36E 28.17 ft.  
 5" Twin Maple N55E 23.62 ft.  
 8" Maple S07W 9.39 ft.  
 6" Maple S71W 26.20 ft.  
 Monument is 0.80 ft. above ground.  
 Bk. 3, Pg. 150

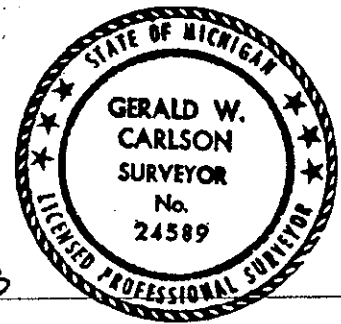

Signed by Gerald W. Carlson  
 Surveyor's Michigan License No. 24589

Date 12-22-93