

1993

JOB NUMBER: 93300  
SHEET NO. : 1-343  
For corners in

LAND CORNER RECORDATION CERTIFICATE  
Filing Requirement of Act 74, Mich. P.A. 1970

RECEIVED FOR RECORDATION  
MARQUETTE COUNTY  
MICHIGAN  
1993 DEC 22 PM 4:15  
Liber 1 R.C. Page 22  
Register of Deeds Stamp & File Number

Located In: MARQUETTE (County)

Corner Code #

1. Public Land Survey	T 48N R 25W	A-11
	T 48N R 26W	M-11
	T _____ R _____	_____
	T _____ R _____	_____
2. Property Controlling in Section	S _____ T _____ R _____	_____
	S _____ T _____ R _____	_____
3. Miscellaneous Property in Sec.	S _____ T _____ R _____	_____
	S _____ T _____ R _____	_____

4. Lot No. \_\_\_\_\_, Recorded Plat \_\_\_\_\_

5. Private Claims \_\_\_\_\_

I, GERALD W. CARLSON, in a field survey on Thursday, December 2, 1993, do hereby certify that under requirements of P.A. 74, Michigan P.A. of 1970, the corner points mentioned in lines 1 and 2 above were in conformance with regulations and rules therefore as required in the current manual of survey instructions of the United States Department of the Interior, Bureau of Land Management or by a decree of a Court of Law and/or that the corner points mentioned in lines 3, 4 and 5 above were in conformance with the rules of the Michigan Board of Land Surveyors or by a Decree of a Court of Law; established, re-established, monumented, re-monumented, recovered, found as expressed below:

NOTE: Not more than 4 corners, all in the same town and range, may be recorded on this certificate.

A	B	C	D	E	F	G	H	I	J	K	L	M
2	6	5	4	3	2							
3												
4	7	8	9	10	11	12						
5												
6	13	17	16	15	14	13						
7												
8	19	20	21	22	23	24						
9												
10	30	29	28	27	26	25						
11												
12	31	32	33	34	35	36						
13												

A. Description of original monument and accessories and/or subsequent restoration:

A-11: Section Corner common to Sections 30 and 31, T48N-R25N and Sections 25 and 36, T48N-R26W. 1845: William A. Burt's original survey notes describe the corner monument as a wood post referenced by:  
 10" Sugar N55E, 9 1  
 12" Y.Birch N70W, 38 1

No date given - Charles Cummings survey indicates the corner as an iron stake. Distance South of this corner indicated by Cummings as 2631.4 ft. No corner accessories given.  
 1940 - Marquette County Road Commission indicates the corner as an old iron pipe about 3" above the surface of the ground. (See reverse side)

B. Description of corner evidence found and/or method applied in restoring or reestablishing corner:


1993 - Found 1" iron pipe with GcVN cap. Distance North checks within 0.05' of C.C.I. The Road Commission distance is 10.4 ft. short. Distance South checks exact to C.C.I. Checks 1.53 ft. short from Marquette County Road Commission and 2.78 ft. short of Cummings. The angle at the SW corner of Section 30 checks to the Marquette County Road Commission Survey of 1940 by 00 03' 16". Replaced 1" iron pipe with GCVN cap with Marquette County Survey Monument. Peer group ratification 11-29-93.

C. Description of monument for corner and accessories established to perpetuate locating the position of the corner:

1993 - Replaced 1" iron pipe with GCVN cap with a 2 1/8" diameter aluminum pipe capped with a 3 1/4" diameter aluminum tablet Marquette County Survey Monument stamped to identify the corner referenced by nails in:

14" White Birch N38E 81.93 ft.  
 6" Maple N57E 71.92 ft.  
 7" Spruce N81E 57.33 ft.  
 12" Maple S58E 50.21 ft.

Monument is 0.6 ft. above ground.  
 Bk. 3, Pg. 136

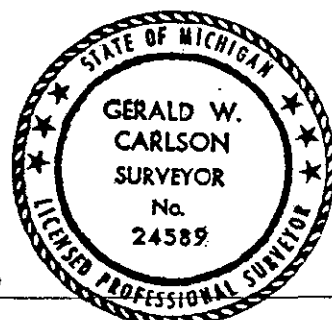

Signed by Gerald W. Carlson Date 12-22-93  
Surveyor's Michigan License No. 24589

Record No. 343

Part "A" Continued:

The post set in the pipe referenced by:

4" White Birch	S63°E	32.3 ft.
6" Balsam	N80°E	37.8 ft.

With coordinates S5339.36, E2606.58.

*Handwritten notes:*  
H 200  
H 400  
H 600  
H 800  
H 1000