

RECEIVED

JUL 03 2000

MARQUETTE COUNTY MICHIGAN RECEIVED FOR RECORD

1996 DEC -4 AM 10:11

SECTION

LAND CORNER RECORDATION CERTIFICATE Filing Requirement of Act 74, Mich. P.A. 1970

Patricia A. Monroy REGISTER OF DEEDS

For corners in MARQUETTE (County) Located In: Corner Code #

1. Public Land Survey T 48N R 25W B-7
2. Property Controlling in Section S T R
3. Miscellaneous Property in Sec. S T R

LIBER R1 PAGE 325 Register of Deeds Stamp & File Number

4. Lot No. , Recorded Plat
5. Private Claims

I, GERALD W. CARLSON, in a field survey on JUNE 28 TH, 19 96, do hereby state that under requirements of P.A. 74, Michigan P.A. of 1970, the corner points mentioned in lines 1 and 2 above were in conformance with regulations and rules therefore as required in the current manual of survey instructions of the United States Department of the Interior, Bureau of Land Management or by a decree of a Court of Law and/or that the corner points mentioned in lines 3, 4 and 5 above were in conformance with the rules of the Michigan Board of Land Surveyors or by a Decree of a Court of Law; established, re-established, monumented, recovered, found as expressed below:

Grid table with columns A-M and rows 1-13. A dot is marked at row 7, column B.

NOTE: Not more than 2 corners, all in the same town and range, may be recorded on this certificate.


A. Description of original monument and accessories and/or subsequent restoration: B-7: Quarter Corner common to Sections 18 and 19. 1845: William Ives' original subdivision survey notes describe the corner monument as a wood post referenced by: 42" W. Pine S68W, 20 L 16" Sugar N66E, 16 L 1892: The corner is indicated in survey notes by George P. Cummings from Record of Surveys page 149. Distance 2624' to S.E. Corner of Section 18. 1969: The corner is shown on a property description map by Robert D. Washburn P.S. #6844, recorded in L. 320, Deeds Pg. 67, and L. 277, Deeds Pg. 235. No corner monument or accessories given.

RATIFIED BY PEER GROUP P.A. 345 OF 1990 Larry J. Busome DATE 11/11/96

1979: An LCRC recorded by Charles F. Clark P.S. #25836, in L. 1, RC Pg. 363, indicates a found nail in C/L bituminous pavement as set by R. Washburn P.S. #6844 - as shown in L. 320, Deeds, pp. 677 and 678. Clark remonumented with a 1/2" X 18" rebar and RLS cap, and referenced by P.K. Nails in: P. Pole North, 24.30' 6" Poplar S45E, 50.30' 6" Poplar S10E, 39.42' 1979: M.C.R.C. field notes by Charles F. Clark P.S. #25836 indicate the corner as a 1/2" X 18" rebar & RLS cap witnessed by: 6" Poplar S45E, 50.30' 6" Poplar S10E, 39.42'

B. Description of corner evidence found and/or method applied in restoring or reestablishing corner: B-7: 1996: Searched and found no evidence of original B.T.'s. Found and accepted a 1/2" re-rod and cap flush with surface at C/L of asphalt road. Cap was cracked and not readable. Checked Line Call (Stream 6 L course North in small ravine, 21.5 chains [1412.4'] West from corner). Measured call: West, 1414', intersected a clear, sand bottom stream, +/- 5' wide, course North in small ravine. Measurement taken on dirt rd. over stream @ C/L culvert, @ extension of Brickyard Road to the West, +/- 100' West of end of pavement. Distance East is 2634.56' and Distance West is 2491.94'.

C. Description of monument for corner and accessories established to perpetuate locating the position of the corner: B-7: 1996: Replaced found iron with a 3/4" X 36" Iron capped with a 3 1/4" aluminum Marquette County Survey Monument stamped to identify the corner. Top of cap is 0.25' below road surface in a set aluminum monument box. Found existing references with nails and face blazes in: 13" Poplar S09E, 39.45' (Clark NBT) 10" Poplar S43E, 50.30' (Clark NBT) Established references: (Using only d.h. nail w/flagging due to nearby houses): 13" W. Birch N12W, 98.63' (Set d.h. nail in E. side of tree, 2.8' high- W. most of two Birches) 5" Apple N49W, 53.57' (Set d.h. nail in S. side of tree, 2.5' high) Green Steel Sign Post w/ Yellow Survey Marker Sign S06W, 39.45' Note: Bearing trees were not painted and no B.T. Tags were affixed due to residential location.

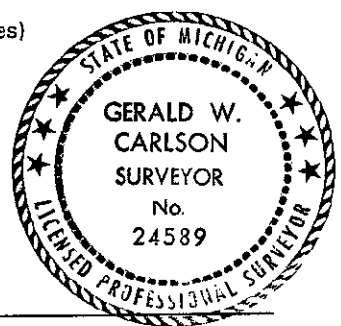

Signed by Gerald W. Carlson Date 12-2-96