

APR 01 1996 LAND CORNER RECORDATION CERTIFICATE

Filing Requirement of Act 74, Mich. P.A. 1970

MARQUETTE COUNTY
RECEIVED FOR RECORD
1995 DEC 27 AM 7:47
REGISTER OF DEEDS

For corners in
MARQUETTE
(County)

COMMISSION

Located In:

Corner Code #


	48N	25W	C-5
1. Public Land Survey	T _____	R _____	_____
	T _____	R _____	_____
	T _____	R _____	_____
	T _____	R _____	_____
2. Property Controlling in Section	S _____	T _____	R _____
	S _____	T _____	R _____
3. Miscellaneous Property in Section	S _____	T _____	R _____
	S _____	T _____	R _____

LIBER 1 PAGE 271
Register of Deeds Stamp & File Number

4. Lot No. _____, Recorded Plat _____
5. Private Claims _____

GERALD W. CARLSON Tuesday, October 24 95

I, _____, in a field survey on _____, 19_____, do hereby certify that under requirements of P.A. 74, Michigan P.A. of 1970, the corner points mentioned in lines 1 and 2 above were in conformance with regulations and rules therefore as required in the current manual of survey instructions of the United States Department of the Interior, Bureau of Land Management or by a decree of a Court of Law and/or that the corner points mentioned in lines 3, 4 and 5 above were in conformance with the rules of the Michigan Board of Professional Surveyors or by a Decree of a Court of Law; established, re-established, monumented, re-monumented, recovered, found as expressed below:

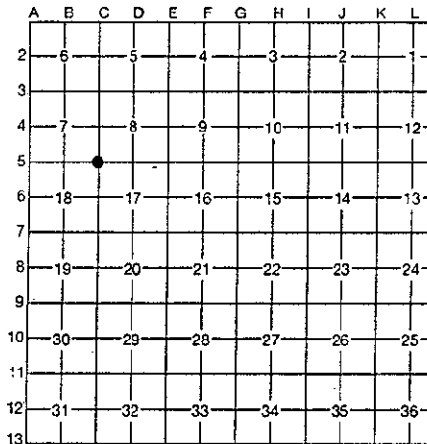

NOTE: Not more than 4 corners, all in the same town and range, may be recorded on this certificate.

A. Description of original monument and accessories and/or subsequent restoration:

- C-5: Section Corner common to Sections 7, 8, 17, and 18. Pg. 129, indicates the corner as being 2755.5' South of the West 1/4 Corner of Section 8. No accessories given.
- 1846: William Ives' original survey notes describe the corner monument as a wood post referenced by:
 - 18" Hemlock S76W, 14 l
 - Y. Birch N26E, 14 l
- 1817: The corner is shown on a Cleveland - Cliffs Iron Co. Transmission Line Abstracts map of Section 18. No Liber and page or corner accessories given.
- 1892: G.P. Cummings, in Record of Surveys Pg. 149, indicates a Distance from the corner to the N.W. Corner of Section 18 of 5090'. Distance to North 1/4 Corner Section 18, distance pro-rated on line between corners, of 2609'.
- 1934+/-: The corner is shown on an Abstract of Title map of Section 7. No Liber and Page or accessories given.
- 1895: G.P. Cummings, County Surveyor, in Record of Surveys (See Reverse Side)
- No Date: The corner is shown on an Upper Peninsula Power Co. Easement Map recorded in L. 65, MR Pages 23-28.

B. Description of corner evidence found and/or method applied in restoring or reestablishing corner:

1995: Found a 2 1/2" diameter, 1.6' high pipe capped with a stamped aluminum cap to identify the corner. Distance East is 2733.49' and Distance West is 5091.41'.

RATIFIED BY PEER GROUP
P.A. 345 OF 1990

Larry J. Bussard
DATE Oct 23, 1995

C. Description of monument for corner and accessories established to perpetuate locating the position of the corner:

1995: Replaced found monument with a 2 3/8" O.D. Aluminum Pipe capped with a 3 1/4" Aluminum Tablet Marquette County Survey Monument stamped to identify the corner. Found existing references with Double Headed Nails in:

7" Maple	S71E,	22.02'
19" Poplar	S08W,	14.25'
15" W. Birch	S17W,	31.51'
15" W. Pine	S77W,	46.64'
Set Green Steel fence Post w/Yellow Survey Marker Sign	N05W,	2.25'

Note: Repainted existing blazes, added butt blazes, and affixed stamped B.T. Tags to bearing trees.

Bk. 11, Pg. 35.

Signed by Gerald W. Carlson

Date 11-13-95

Surveyor's Michigan License No. _____

24589

FORM APPROVED BY MICHIGAN STATE BOARD OF PROFESSIONAL SURVEYORS, JAN. 28, 1977



Record No. 600:

Part A Continued:

1975: A Certificate of Survey recorded by Robert F. Cambensy RLS #19616, in L. 1, SM Pg. 127, indicates the corner as a found 2" Iron Pipe with Brass Cap referenced by:

20" Poplar	S30W,	16.95'
15" Maple	Due East,	24.70'
18" Poplar	S01W,	13.70'

Handwritten:
R.F. Cambensy
RLS #19616