

SECTION

LAND CORNER RECORDATION CERTIFICATE
Filing Requirement of Act 74, Mich. P.A. 1970

MARQUETTE COUNTY MICHIGAN RECEIVED FOR RECORD 1998 DEC 29 PM 3:21

Patricia L. Mosley REGISTER OF DEEDS

For corners in MARQUETTE (County) Located In: Corner Code #
1. Public Land Survey T 48N R 25W C-11
2. Property Controlling in Section S T R
3. Miscellaneous Property in Sec. S T R

LIBER R2 PAGE 107 Register of Deeds Stamp & File Number

4. Lot No. , Recorded Plat
5. Private Claims

I, GERALD W. CARLSON, in a field survey on MAY 19TH, 1998, do hereby state that under requirements of P.A. 74, Michigan P.A. of 1970, the corner points mentioned in lines 1 and 2 above were in conformance with regulations and rules therefore as required in the current manual of survey instructions of the United States Department of the Interior, Bureau of Land Management or by a decree of a Court of Law and/or that the corner points mentioned in lines 3, 4 and 5 above were in conformance with the rules of the Michigan Board of Land Surveyors or by a Decree of a Court of Law; established, re-established, monumented, recovered, found as expressed below:

Grid table with columns A-L and rows 1-13. A dot is marked at row 11, column C.

NOTE: Not more than 2 corners, all in the same town and range, may be recorded on this certificate.

A. Description of original monument and accessories and/or subsequent restoration:

C-11: Corner common to Sections 29, 30, 31, and 32. 1845: William Ives' original subdivision survey notes describe the corner monument as a wood post referenced by: 14" Hemlock S45W, 31 L 14" Y. Birch N56E, 32 L

No Date: The M.C.R.C. Government Corner Index Book for Section 30 indicates the corner as a concrete monument for the proposed "Assessor's Plat of Northwood Lane Acres". No accessories given.

1976: A Certificate of Survey by William R. Donnan P.S. #17618 (No Liber or page given) indicates the corner as a set 1 1/8" Iron Pipe. Distance N89-35'-20"E, 2683.51' to a set 5/8" rod at the South 1/4 Corner of Section 29. 1 1/8" Iron Pipe referenced by: 12" Hemlock N36E, 23.62' 5" Maple N03W, 24.12' 4" Maple S42W, 6.51'

1984: An LCRC recorded by Larry J. Bussone P.S. # 25833 in L. 4, RC Pg. 385, indicates no original corner evidence found. He found a 1" Pipe Corner, origin unknown; used in local surveys. Referenced by trees with upper and lower notches: 13" Spruce N38E, 23.7' (Donnan NBT) 8" Poplar S33E, 3.2' 3" Maple S45W, 6.3' (Donnan NBT) 6" Maple N01W, 24.0' (Donnan NBT) (SEE REVERSE SIDE)

B. Description of corner evidence found and/or method applied in restoring or reestablishing corner:

C-11: 1998: No original corner evidence found. Found and accepted a 1" pipe, 2.15' high. Bearing and distance to 1 remaining fd. reference check very well with those recorded in L. 4, RC pg. 385 (other 3 trees on this record are dead and fallen). Section line North and South from corner was found to be painted and blazed. Checked Line Call: Stream 15 L Course E. in Ravine, 12.70 chains [838.20'] North from corner. Measured call: North 940' to South Bank of 15' +/- wide Stream, Course E.'ly. Checked Line Call: Stream 16 L at South end ravine, 1.60 chains [105.60'] East from corner. Measured Call: East 180' to West bank of Stream (steep drop). Both line calls were measured with a hip chain. Distance East is 2682.26', North is 2613.38', West is 2592.77' and South is 2633.13'

C. Description of monument for corner and accessories established to perpetuate locating the position of the corner:


C-11: 1998: Replaced found Pipe with a 2 3/8" O.D. aluminum pipe capped with a 3 1/4" diameter aluminum tablet Marquette County Survey Monument stamped to identify the corner. Monument is 0.75' above ground. Measured to set d.h. nail in found reference: 7" Maple N01E, 24.02' (Donnan NBT) Established new references: 8" Maple N10E, 3.57' 14" Maple S81E, 23.38' 8" Maple S27W, 21.42'

Green Steel Sign Post w/ Yellow Survey Marker Sign S77W, 2.96'

Note: Bearing trees have painted face, butt, and side nail blazes, d.h. measuring nails, and stamped B.T. Tags affixed.

RATIFIED BY PEER GROUP P.A. 345 OF 1990

Larry J. Bussone DATE 11/20/98 Date 12-28-98

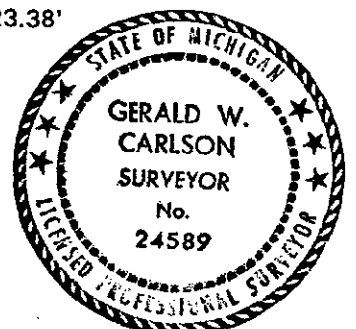

Signed by Gerald W. Carlson

Surveyor's Michigan License No. 24589


C-11:
PART A CONTINUED: SECTION

- 1990: The corner is indicated on an Easement Description Map (Exhibit A) for Wisconsin Electric by Sundberg, Carlson, and Associates, recorded in L. 130, MR Pg. 749. No description of corner object or accessories given.
- 1994: A Certificate of Survey by Gerald W. Carlson P.S. #24589 (No Liber and page given) indicates the corner. Distance N88-57'-37"E, 2682.76' to the South 1/4 Corner of Section 29. No description of corner object or accessories given.
- 1994: The corner is shown on The Assessor's Plat of Lake Enchantment recorded in L. 12, Plats pp. 340A - 342A, as surveyed by Gerald W. Carlson P.S. #24589. Reference is made to the corner as recorded in L. 4, RC Pg. 385.