

APR 01 1996

JOB NUMBER: 95053  
SHEET NO. : 1-591


COMMISSION LAND CORNER RECORDATION CERTIFICATE  
Filing Requirement of Act 74, Mich. P.A. 1970

MARQUETTE COUNTY  
RECEIVED FOR RECORD  
1995 DEC 27 AM 7:47  
REGISTER OF DEEDS  
*Johnnie A. Woodbury*

| For corners in                          | Located In:               | Corner Code # |
|---|---------------------------|---------------|
| <u>MARQUETTE</u><br>(County)            |                           |               |
| 1. Public Land Survey                   | T <u>48N</u> R <u>25W</u> | <u>E-3</u>    |
|   | T _____ R _____           | _____         |
|   | T _____ R _____           | _____         |
|   | T _____ R _____           | _____         |
| 2. Property Controlling<br>in Section   | S _____ T _____ R _____   | _____         |
|   | S _____ T _____ R _____   | _____         |
| 3. Miscellaneous<br>Property in Section | S _____ T _____ R _____   | _____         |
|   | S _____ T _____ R _____   | _____         |

LIBER 1 PAGE 264  
Register of Deeds Stamp & File Number

4. Lot No. \_\_\_\_\_, Recorded Plat \_\_\_\_\_  
5. Private Claims \_\_\_\_\_

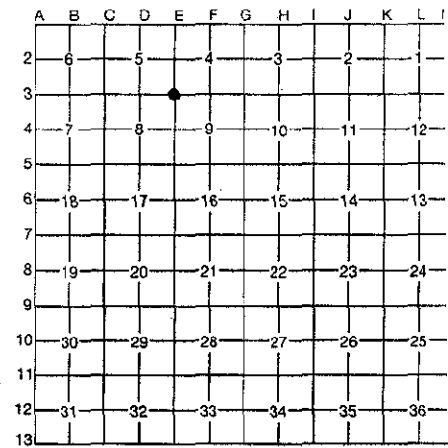

I, GERALD W. CARLSON, in a field survey on Wednesday, October 18, 1995, do hereby certify that under requirements of P.A. 74, Michigan P.A. of 1970, the corner points mentioned in lines 1 and 2 above were in conformance with regulations and rules therefore as required in the current manual of survey instructions of the United States Department of the Interior, Bureau of Land Management or by a decree of a Court of Law and/or that the corner points mentioned in lines 3, 4 and 5 above were in conformance with the rules of the Michigan Board of Professional Surveyors or by a Decree of a Court of Law; established, re-established, monumented, re-monumented, recovered, found as expressed below:

**NOTE: Not more than 4 corners, all in the same town and range, may be recorded on this certificate.**

**A. Description of original monument and accessories and/or subsequent restoration:**


- 7" Y. Pine S75E, 11.1
- 7" Y. Pine S81W, 33.1

1895: G.P. Cummings, County Surveyor, in Record of Surveys Pages 129 & 131, indicates the corner as having been set from original GLO bearing trees. No corner accessories given.

No date: The corner is shown on an Upper Peninsula Power Company easement map recorded in L. 86, MR Pg. 595.

1988: An LCRC recorded by Gerald W. Carlson RLS #24589, in L. 5, RC Pg. 156, indicates a set 5/8" re-rod with LS cap #24589, drilled and grouted at the corner position. Iron replaced a found wood post in a mound of stones on top of a granite knob. Distances North, South, East, and West of this position checked well. References established:

- 10" R. Pine S32W, 4.57'
- 11" R. Pine S22E, 14.27'
- 10" R. Pine N28E, 16.09'
- 12" R. Pine N23W, 33.30'

**B. Description of corner evidence found and/or method applied in restoring or reestablishing corner:**

1995: Found and accepted a 5/8" Iron grouted in rock as described by G. Carlson in Part A above. Iron is missing cap. Distance South is 2661.65' and Distance East is 2642.63'.

RATIFIED BY PEER GROUP  
P.A. 345 OF 1990

*Larry J. Busone*  
DATE Oct. 16, 1995

**C. Description of monument for corner and accessories established to perpetuate locating the position of the corner:**

1995: Set a 3" diameter Aluminum Cap, stamped to identify the corner, on a found 5/8" Iron grouted in rock. Referenced by existing double headed nails w/washers in:

|             |       |        |             |
|-------------|-------|--------|-------------|
| 10" R. Pine | S25W, | 4.59'  | Carlson NBT |
| 11" R. Pine | S26E, | 14.30' | Carlson NBT |
| 10" R. Pine | N26E, | 16.10' | Carlson NBT |
| 12" R. Pine | N25W, | 33.28' | Carlson NET |

Note: Monument remains 0.3' above ground. Ground was too rocky to set a steel fence post and sign, so we nailed a Survey Marker Sign on the SW Bearing Tree (4.59' away). Bearing Trees were repainted, butt blazes added, and B.T. Tags affixed. Bk. 11, Pg. 17.

Signed by Gerald W. Carlson

Date 11-13-95

Surveyor's Michigan License No. 24589

FORM APPROVED BY MICHIGAN STATE BOARD OF PROFESSIONAL SURVEYORS JAN. 1971

