

JOB NUMBER: 95053
SHEET NO. : 1-593

RECORDATION

LAND CORNER RECORDATION CERTIFICATE

APR 01 1996 Filing Requirement of Act 74, Mich. P.A. 1970

For corners in

Located In:	Corner Code #
MARQUETTE (County) COMMISSION	E-4
1. Public Land Survey	T ^{48N} R ^{25W}
	T _____ R _____
	T _____ R _____
	T _____ R _____
2. Property Controlling in Section	S _____ T _____ R _____
	S _____ T _____ R _____
3. Miscellaneous Property in Section	S _____ T _____ R _____
	S _____ T _____ R _____


REGISTER OF DEEDS

1995 DEC 27 AM 7:47

MARQUETTE COUNTY MICHIGAN RECEIVED FOR RECORD

LIBER 1 PAGE 269 Register of Deeds Stamp & File Number

4. Lot No. _____, Recorded Plat _____
5. Private Claims _____

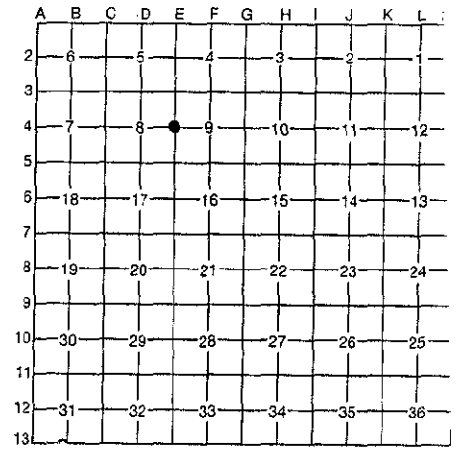

I, GERALD W. CARLSON, in a field survey on Wednesday, October 18, 1995, do hereby certify that under requirements of P.A. 74, Michigan P.A. of 1970, the corner points mentioned in lines 1 and 2 above were in conformance with regulations and rules therefore as required in the current manual of survey instructions of the United States Department of the Interior, Bureau of Land Management or by a decree of a Court of Law and/or that the corner points mentioned in lines 3, 4 and 5 above were in conformance with the rules of the Michigan Board of Professional Surveyors or by a Decree of a Court of Law; established, re-established, monumented, re-monumented, recovered, found as expressed below:

NOTE: Not more than 4 corners, all in the same town and range, may be recorded on this certificate.

A. Description of original monument and accessories and/or subsequent restoration:

E-4: Quarter Corner common to Sections 8 and 9. 1846: William Ives' original survey notes describe the corner monument as a wood post referenced by:

- 8" Hemlock N21W, 26.1
- 10" Hemlock S42E, 23.1

1895: G.P. Cummings, County Surveyor, indicates the corner was established on corrected line equidistant between corners, and marked with a hexagonal steel bar.

1988: A Land Corner Certificate recorded by Gerald W. Carlson RLS #24589, in L. 5, RC Pg. 148, indicates a 5/8" X 18" iron with LLS cap #24589 set equal distance and on line between the S.W. and N.W. Section Corners. No evidence of a Cummings iron was found. Referenced by:

- 18" R. Pine S84E, 26.02'
- 7" Maple N23W, 24.29'
- 14" R. Pine S46E, 28.28'
- 8" Maple S50W, 11.16'

1990: An Easement Description Map (Exhibit A) recorded by Gerald W. Carlson RLS #24589 in L. 132, MR Pg. 447 indicates the corner. No accessories given.

B. Description of corner evidence found and/or method applied in restoring or reestablishing corner:

1995: Found and accepted a 5/8" Re-rod and LLS Cap #24589 as described in Part A above (1988). Distance North is 2661.65' and Distance South is 2662.01'.

RATIFIED BY PEER GROUP
P.A. 345 OF 1990

Larry J. Bussone
DATE Oct. 16, 1995

C. Description of monument for corner and accessories established to perpetuate locating the position of the corner:

1995: Replaced 5/8" Iron with Cap #24589 with a 2 3/8" diameter aluminum pipe capped with a 3 1/4" diameter aluminum tablet Marquette County Survey Monument stamped to identify the corner. Referenced by nails in:

- 18" R. Pine S84E, 26.02' Carlson NBT
- 7" Oak N23W, 24.29' Carlson NBT
- 14" R. Pine S46E, 28.28' Carlson NBT
- 8" Oak S50W, 11.16' Carlson NBT
- Green Steel Fence Post w/ Yellow Survey Marker Sign S66E, 0.97'

Note: Monument is flush with ground. Bearing Trees were repainted, butt blazes added, and B.T. Tags affixed.
Ek. 11, Pg. 13.

Signed by *Gerald W. Carlson*
Surveyor's Michigan License No. 24589

Date 11-13-95

FORM APPROVED BY MICHIGAN STATE BOARD OF PROFESSIONAL SURVEYORS, JAN 1971

