

SURVEY & REMONUMENTATION

JOB NUMBER: 94030
SHEET NO. : 1-436

APR 28 1995

LAND CORNER RECORDATION CERTIFICATE Filing Requirement of Act 74, Mich. P.A. 1970

MARQUETTE COUNTY
MICHIGAN
RECEIVED FOR RECORD
1994 DEC 28 PM 5:54

For corners in **COMMISSION**

<u>MARQUETTE</u> <small>(County)</small>	Located In:	Corner Code <u>##</u>
1. Public Land Survey	T <u>48N</u> R <u>25W</u>	<u>E-13</u>
	T _____ R _____	_____
	T _____ R _____	_____
	T _____ R _____	_____
2. Property Controlling in Section	S _____ T _____ R _____	_____
	S _____ T _____ R _____	_____
3. Miscellaneous Property in Sec.	S _____ T _____ R _____	_____
	S _____ T _____ R _____	_____
4. Lot No. _____, Recorded Plat _____		
5. Private Claims _____		

Patricia A. Menley
REGISTER OF DEEDS

LIBER **1** PAGE **111**
Register of Deeds Stamp & File Number

	A	B	C	D	E	F	G	H	I	J	K	L	M
2	6	5	4	3	2	1							
3													
4	7	8	9	10	11	12							
5													
6	18	17	16	15	14	13							
7													
8	19	20	21	22	23	24							
9													
10	30	29	28	27	26	25							
11													
12	31	32	33	34	35	36							
13													

I, GERALD W. CARLSON, in a field survey on Wednesday, November 30, 1994, do hereby certify that under requirements of P.A. 74, Michigan P.A. of 1970, the corner points mentioned in lines 1 and 2 above were in conformance with regulations and rules therefore as required in the current manual of survey instructions of the United States Department of the Interior, Bureau of Land Management or by a decree of a Court of Law and/or that the corner points mentioned in lines 3, 4 and 5 above were in conformance with the rules of the Michigan Board of Land Surveyors or by a Decree of a Court of Law; established, re-established, monumented, re-monumented, recovered, found as expressed below:

NOTE: Not more than 4 corners, all in the same town and range, may be recorded on this certificate.

A. Description of original monument and accessories and/or subsequent restoration:

E-13: Section Corner common to Sections 32 and 33, T48N-R25W. 1844: William A. Burt's original survey notes describe the corner monument as a wood post referenced by: 10" Fir N48E, 17 l 8" Maple N15W, 16 l	1912: CCI notes corner position on Iron Cliffs Co. easement map dated May, 1912. No date. C. Cummings indicates he set the corner from Bearing Trees 5314' East of SW Corner Section 32. (See reverse side).
--	--

B. Description of corner evidence found and/or method applied in restoring or reestablishing corner:

1994 - Found and accepted iron as placed by G. Carlson in 1988.
Distance West is 2654.52' and distance East is 2594.63'.


RATIFIED BY PEER GROUP.
P.A. 345 OF 1990
Larry J. Bussom
DATE Oct. 3, 1994

C. Description of monument for corner and accessories established to perpetuate locating the position of the corner:

1994 - Replaced 5/8" iron and cap #24589 with a 2 1/2" diameter aluminum pipe capped with a 3 1/4" diameter aluminum tablet Marquette County Survey Monument stamped to identify the corner referenced by nails in:

10" Maple	S69E	8.17 ft.	Carlson NBT
13" Twin Maple	S32E	16.68 ft.	
11" Maple	S22W	6.04 ft.	Carlson NBT
4" Maple	N19W	10.22 ft.	Carlson NBT

Steel sign post East 1.0 ft.
Monument is 0.30' above ground.
Bk. 5, Pg. 67

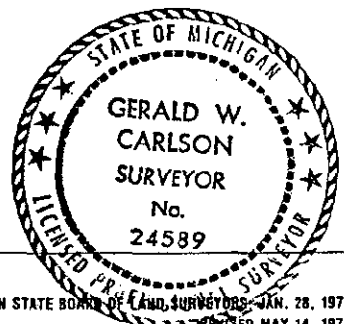

Signed by Gerald W. Carlson

Date 12-22-94

Surveyor's Michigan License No. 24589

Record No. 436:

Part "A" Continued:

1988 - G. Carlson set a 5/8" x 18" iron w/LLS cap at C. Cummings pro rated distance from the found S.E. Corner Section 5, T47N-R25W and the re-established S.W. Corner of Section 32, T48N-R25W. No original evidence found. Referenced by:

4" Hemlock,	N59E,	10.30'
4" Maple,	N05E,	10.27'
10" Maple,	S77E,	8.14'
9" Maple,	S20W,	6.02'

This corner was not recorded.

*Rte 6
9th
200 ft.*