

JOB NUMBER: 95053
SHEET NO. : 1-590

APR 01 1996

LAND CORNER RECORDATION CERTIFICATE
Filing Requirement of Act 74, Mich. P.A. 1970

For corners in
MARQUETTE
(County)

Located In:

Corner Code #


	48N	25W	P-3
1. Public Land Survey	T	R	
	T	R	
	T	R	
	T	R	
2. Property Controlling in Section	S	T	R
	S	T	R
3. Miscellaneous Property in Section	S	T	R
	S	T	R

Gerald W. Carlson
REGISTER OF DEEDS

MARQUETTE COUNTY
MICHIGAN
RECEIVED FOR RECORD
1995 DEC 27 AM 7:47

LIBER 1 PAGE 265
Register of Deeds Stamp & File Number

4. Lot No. _____, Recorded Plat _____
5. Private Claims _____

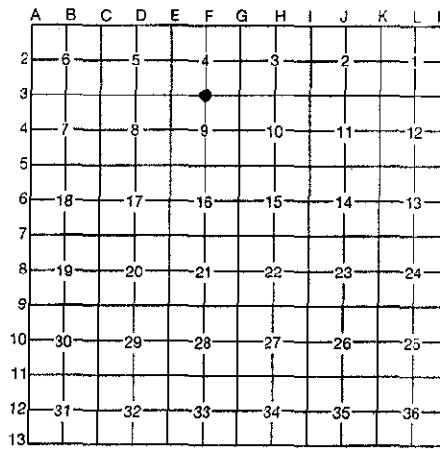

GERALD W. CARLSON Wednesday, October 18 95

I, _____, in a field survey on _____, 19_____, do hereby certify that under requirements of P.A. 74, Michigan P.A. of 1970, the corner points mentioned in lines 1 and 2 above were in conformance with regulations and rules therefore as required in the current manual of survey instructions of the United States Department of the Interior, Bureau of Land Management or by a decree of a Court of Law and/or that the corner points mentioned in lines 3, 4 and 5 above were in conformance with the rules of the Michigan Board of Professional Surveyors or by a Decree of a Court of Law; established, re-established, monumented, re-monumented, recovered, found as expressed below:

NOTE: Not more than 4 corners, all in the same town and range, may be recorded on this certificate.

A. Description of original monument and accessories and/or subsequent restoration:

P-3: Quarter Corner common to Sections 4 and 9. 1846: William Ives' original survey notes describe the corner monument as a wood post on large base Granite knob referenced by:

- 6" Spruce S25W, 08 1
- 5" Spruce N41E, 15 1

1891+/-: G.P. Cummings, County Surveyor, in Record of Surveys Pg. 130, indicates the corner as being set from original GLO bearing trees. No accessories given.
No date: The corner is indicated on an Upper Peninsula Power Co. easement map recorded in L. 86, MR Pg. 595.

1988: An LCRC recorded by Gerald W. Carlson RLS #24589, in L. 5, RC Pg. 157, indicates the corner as a set 5/8" X 18" re-rod with LS cap #24589, drilled and grouted in granite rock on line and equal distance between the S.W. and S.E Corners of Section 4. References established:

- 14" W. Pine N72E, 33.24'
- 8" J. Pine N44W, 23.63'
- 6" J. Pine N75W, 23.78'
- 12" W. Pine S75W, 34.27'

B. Description of corner evidence found and/or method applied in restoring or reestablishing corner:

1995: Found and accepted a 5/8" Iron with G. Carlson cap #24589 as described in Part A above. Distance East is 2642.70' and Distance West is 2642.63'.

RATIFIED BY PEER GROUP
P.A. 345 OF 1990

Larry J. Bussard
DATE Oct 16, 1995

C. Description of monument for corner and accessories established to perpetuate locating the position of the corner:

1995: Removed Cap #24589, and set a 3" diameter Aluminum Cap, stamped to identify the corner, on the found 5/8" Iron. Piled rocks around the monument, removed old grown-over nails from references and replaced with new double headed nails in:

- 14" W. Pine N72E, 33.22' Carlson NBT
- 8" J. Pine N44W, 23.65' Carlson NBT
- 6" J. Pine N75W, 23.79' Carlson NBT
- 13" W. Pine S75W, 34.30' Carlson NBT

Note: The ground is all rock so it was impossible to set steel fence post with sign. Monument remains 0.6' above ground. Bearing trees were repainted, butt blazes added, and B.T. Tags affixed.
Bk. 11, Pg. 15.

Signed by *Gerald W. Carlson*
24589

Date 11-3-95

Surveyor's Michigan License No. _____

FORM APPROVED BY MICHIGAN STATE BOARD OF PROFESSIONAL SURVEYORS, JAN 27 1971
REVISED MAY 19 1975
REVISED JAN 1983

