

# SURVEY & REMONUMENTATION

JOB NUMBER: 94030  
SHEET NO. : 1-438

APR 28 1995 **LAND CORNER RECORDATION CERTIFICATE**  
Filing Requirement of Act 74, Mich. P.A. 1970

For corners in

**COMMISSION**

<u>MARQUETTE</u> <small>(County)</small>	Located in:	Corner Code #
1. Public Land Survey	T <u>48N</u> R <u>25W</u>	<u>F-13</u>
	T _____ R _____	_____
	T _____ R _____	_____
	T _____ R _____	_____
2. Property Controlling in Section	S _____ T _____ R _____	_____
	S _____ T _____ R _____	_____
3. Miscellaneous Property in Sec.	S _____ T _____ R _____	_____
	S _____ T _____ R _____	_____
4. Lot No. _____, Recorded Plat _____		
5. Private Claims _____		

MARQUETTE COUNTY  
MICHIGAN  
RECEIVED FOR RECORD  
1994 DEC 28 PM 5:51

*Patricia A. Moulton*  
REGISTER OF DEEDS

LIBER **1** PAGE **113**  
Register of Deeds Stamp & File Number

	A	B	C	D	E	F	G	H	I	J	K	L	M
2	6	5	4	3	2	1							
3													
4	7	8	9	10	11	12							
5													
6	18	17	16	15	14	13							
7													
8	19	20	21	22	23	24							
9													
10	30	29	28	27	26	25							
11													
12	31	32	33	34	35	36							
13													

I, GERALD W. CARLSON, in a field survey on Tuesday, December 27, 1994, do hereby certify that under requirements of P.A. 74, Michigan P.A. of 1970, the corner points mentioned in lines 1 and 2 above were in conformance with regulations and rules therefore as required in the current manual of survey instructions of the United States Department of the Interior, Bureau of Land Management or by a decree of a Court of Law and/or that the corner points mentioned in lines 3, 4 and 5 above were in conformance with the rules of the Michigan Board of Land Surveyors or by a Decree of a Court of Law; established, re-established, monumented, re-monumented, recovered, found as expressed below:

**NOTE: Not more than 4 corners, all in the same town and range, may be recorded on this certificate.**

**A. Description of original monument and accessories and/or subsequent restoration:**

F-13: South Quarter Corner Section 33, T48N-R25W. 1844:  
William A. Burt's original survey notes describe the corner monument as a wood post referenced by:  
7" Spruce N14E, 30 l  
10" Cedar N28W, 3 l

**B. Description of corner evidence found and/or method applied in restoring or reestablishing corner:**


1994: No original evidence found. Corner position established equidistant and on line between the SW and SE Corners of Section 33. GLO call to Top of Hill 561' East of corner checks within 2' and GLO call to stream 594' West of Corner checks within 4'. The distances East and West are 2594.63'. North 1/4 Corner Section 4, T47N-R25W is West, 17.16'.

**RATIFIED BY PEER GROUP  
P.A. 345 OF 1990**

*Gary J. Busan*  
DATE Oct. 3, 1994

**C. Description of monument for corner and accessories established to perpetuate locating the position of the corner:**

1994 - Set a 2 1/2" diameter aluminum pipe capped with a 3 1/4" diameter aluminum tablet Marquette County Survey Monument stamped to identify the corner referenced by nails in:  
3" Maple N48E 7.90 ft.  
6" Maple S60E 16.48 ft.  
7" Maple S41W 10.55 ft. (cluster of 3 trees)  
8" Maple S89W 11.53 ft. (cluster of 4 trees)  
Steel sign post North 1.0 ft.  
Monument is 0.2' above ground and located on steep side slope of North-South ridge.  
Bk. 8, Pg. 79

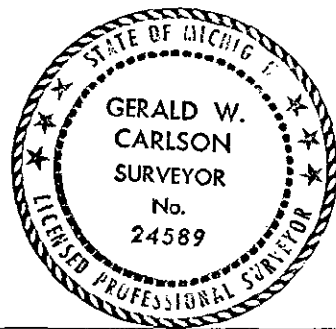

Signed by Gerald W. Carlson

Date 12-28-94

Surveyor's Michigan License No. 24589