

JOB NUMBER: 95053  
 SHEET NO. : 1-605

APR 01 1996

**LAND CORNER RECORDATION CERTIFICATE**  
**Filing Requirement of Act 74, Mich. P.A. 1970**

MARQUETTE COUNTY  
 RECEIVED FOR RECORD  
 1995 DEC 27 AM 7:48  
 REGISTER OF DEEDS  
*Patricia A. Henderson*

For corners in \_\_\_\_\_ Located In: \_\_\_\_\_ Corner Code # \_\_\_\_\_  
 MARQUETTE (County)

1. Public Land Survey	T <u>48N</u>	R <u>25W</u>	H-7 _____
	T _____	R _____	_____
	T _____	R _____	_____
	T _____	R _____	_____
2. Property Controlling in Section	S _____	T _____	R _____
	S _____	T _____	R _____
3. Miscellaneous Property in Section	S _____	T _____	R _____
	S _____	T _____	R _____

LIBER 1 PAGE 281  
 Register of Deeds Stamp & File Number

4. Lot No. \_\_\_\_\_, Recorded Plat \_\_\_\_\_  
 5. Private Claims \_\_\_\_\_

A	B	C	D	E	F	G	H	I	J	K	L
2	6	5	4	3	2						
3											
4	7	8	9	10	11	12					
5											
6	18	17	16	15	14	13					
7											
8	19	20	21	22	23	24					
9											
10	30	29	28	27	26	25					
11											
12	31	32	33	34	35	36					
13											

I, GERALD W. CARLSON, in a field survey on Wednesday, October 25, 1995, do hereby certify that under requirements of P.A. 74, Michigan P.A. of 1970, the corner points mentioned in lines 1 and 2 above were in conformance with regulations and rules therefore as required in the current manual of survey instructions of the United States Department of the Interior, Bureau of Land Management or by a decree of a Court of Law and/or that the corner points mentioned in lines 3, 4 and 5 above were in conformance with the rules of the Michigan Board of Professional Surveyors or by a Decree of a Court of Law; established, re-established, monumented, re-monumented, recovered, found as expressed below:

**NOTE: Not more than 4 corners, all in the same town and range, may be recorded on this certificate.**

**A. Description of original monument and accessories and/or subsequent restoration:**

H-7: Quarter Corner common to Sections 15 and 22. 1846: William Ives' original survey notes describe the corner monument as a wood post referenced by: 10" Aspen N45W, 10 1 6" Aspen S05E, 12 1 1887: The corner is shown on the Plat of Nester's Addition No. 1 recorded by George Cummings in L.2, Plats Pg. 6. 1890: G.P. and Charles Cummings in Record of Surveys Pg. 143, indicate the corner as an iron pipe 2613' East of the S.W. Corner of Section 15, and 2524' West of the S.E. Corner (See Reverse Side).	of Section 15. No accessories given. 1892: The corner is shown on the Plat of West End Addition recorded by George P. Cummings in L. 3, Plats Pg. 10. 1917: The corner is shown on the Plat of Asire's Addition recorded by Charles Cummings in L. 4, Plats Pg. 22. No Date: Charles Cummings, in Record of Surveys Pg. 157, indicates the corner as being 2669.0' North of the Center of Section 22, and 5307' North of the South 1/4 Corner of Section 22. No accessories given.
--	---

**B. Description of corner evidence found and/or method applied in restoring or reestablishing corner:**

1995: Found and accepted concrete monument, 1.0' West of parking lot edge of metal, 0.1' below grade, with 1/2" inserted bar 0.3' exposed, no cap, and tipped West as referenced above in Part "A". Distance East is 2624.62', Distance West is 2613.38', and Distance South is 5309.40'. Distance S54-36-09E, 4.26' to a 5/8" Iron with Cap #24589.

**RATIFIED BY PEER GROUP  
 P.A. 345 OF 1990**


*Larry J. Bussink*  
 DATE 10/16/95

**C. Description of monument for corner and accessories established to perpetuate locating the position of the corner:**

1995: Replaced found concrete monument with a 2 3/8" O.D. Aluminum Pipe capped with a 3 1/4" Aluminum Tablet Marquette County Survey Monument, 0.25' below ground, and stamped to identify the corner. Used existing witnesses with found P.K. Nails and Plastic Washers "ECI 30097" in Power Poles:

S.W. Corner Apt. Bldg.	N29E,	38.28' ECI Accessory
P. Pole	S30E,	56.88' ECI Accessory
P. Pole	N87E,	64.11' ECI Accessory
P. Pole	S55W,	80.03' ECI Accessory
11" W. Birch	S45W,	104.23' (Set D.H. Nail-No Blaze)
7" Maple	N10W,	45.03' (Set D.H. Nail-No Blaze)
9" Maple	N04W,	67.11' (Set D.H. Nail-No Blaze)

Note: Placed Yellow Survey Marker Sign on P. Pole N87E, 64.11.

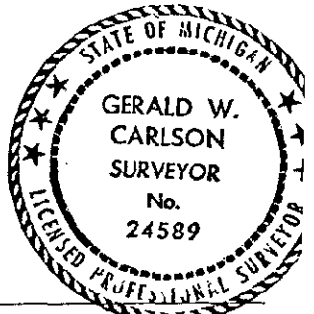

Ek. 11, Pg. 37.  
 Signed by Gerald W. Carlson

Date 12-15-95

Surveyor's Michigan License No. 24589

