

**LAND CORNER RECORDATION CERTIFICATE**  
Filing Requirement of Act 74, Mich. P.A. 1970

For corners in  
MARQUETTE  
(County)

APR 01 1996

Located In:


Corner Code #

	48N	25W	H-9
1. Public Land Survey	T _____	R _____	_____
	T _____	R _____	_____
	T _____	R _____	_____
	T _____	R _____	_____
2. Property Controlling in Section	S _____	T _____	R _____
	S _____	T _____	R _____
3. Miscellaneous Property in Section	S _____	T _____	R _____
	S _____	T _____	R _____

MARQUETTE COUNTY  
 RECEIVED FOR RECORD  
 1995 DEC 27 AM 7:49  
 REGISTERED PROFESSIONAL SURVEYOR  
 GERALD W. CARLSON

LIBER 1 PAGE 28  
Register of Deeds Stamp & File Number

4. Lot No. \_\_\_\_\_, Recorded Plat \_\_\_\_\_  
5. Private Claims \_\_\_\_\_

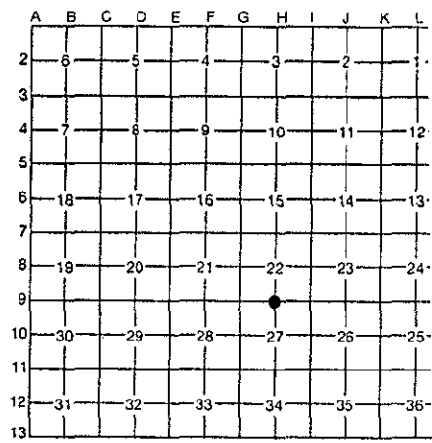

GERALD W. CARLSON Wednesday, October 25 95

I, \_\_\_\_\_, in a field survey on \_\_\_\_\_, 19\_\_\_\_\_, do hereby certify that under requirements of P.A. 74, Michigan P.A. of 1970, the corner points mentioned in lines 1 and 2 above were in conformance with regulations and rules therefore as required in the current manual of survey instructions of the United States Department of the Interior, Bureau of Land Management or by a decree of a Court of Law and/or that the corner points mentioned in lines 3, 4 and 5 above were in conformance with the rules of the Michigan Board of Professional Surveyors or by a Decree of a Court of Law; established, re-established, monumented, re-monumented, recovered, found as expressed below:

**NOTE: Not more than 4 corners, all in the same town and range, may be recorded on this certificate.**

**A. Description of original monument and accessories and/or subsequent restoration:**

H-9: Quarter Corner common to Sections 22 and 27. 1846: William Ives' original survey notes describe the corner monument as a wood post referenced by:  
 10" Sugar N55W, 18 1  
 14" Sugar S76E, 25 1  
 1911: Charles Cummings in Record of Surveys Pg. 165, indicates the corner as being 2638' North of the Center 1/4 Corner of Section 27. No accessories given.  
 No Date: George P. Cummings, in Record of Surveys Pg. 157, indicates the corner as being 5307' South of the North 1/4 Corner of Section 22. No accessories given.  
 1992: An LCRC recorded by Robert F. Cambensy RLS #19616, in L. 5, RC Pg. 340, indicates the corner as being restored from notes of surveys by George P. Cummings and Charles Cummings, 1907 through 1916, from measurements to original transmission pole locations described in the Cummings surveys, and from measurements to the recorded plats of Homestead Addition (L. 3, Plats Pg. 11) and Forest Park Sub-division (L. 8, Plats Pages 1 & 2). (See Reverse Side)

**B. Description of corner evidence found and/or method applied in restoring or reestablishing corner:**

1995: Found and accepted a 5/8" iron grouted in concrete, 0.4' above grade, with cap #19616, as recorded in L. 5, RC Pg. 340. Distance East is 2585.43', Distance West is 2694.04', Distance South is 5312.37', and Distance North is 5309.40'.

**RATIFIED BY PEER GROUP  
P.A. 345 OF 1990**

*Larry J. Bussinec*  
DATE Oct. 23, 1995

**C. Description of monument for corner and accessories established to perpetuate locating the position of the corner:**

1995: Removed Cap from found 5/8" Iron and replaced it with a 3" diameter Aluminum Tablet Marquette County Survey Monument, 0.4' above ground, and stamped to identify the corner. Referenced by:

- 6" Spruce S89W, 13.29' Cambensy NBT-D.H. Nail Set By SCA
- 6" Ironwood S35E, 22.33' Cambensy NBT-Fd. Nail w/Washer
- 18" Maple S74E, 43.76' Cambensy NBT-Fd. Nail w/Washer
- 8" Maple N43E, 43.39' Cambensy NBT-Fd. Nail w/Washer

Set a Green Steel Sign Post w/ Yellow Survey Marker Sign 1' North of corner.

Note: Repainted existing blazes and added butt blazes to bearing trees.

Bk. 10, Pg. 45.



Signed by Gerald W. Carlson  
24589

Date 11-13-95

Surveyor's Michigan License No. \_\_\_\_\_

Record No. 609:

*Ref  
See Part 1*

**Part A Continued:**

Occupation near the East-West Quarter-lines of Sections 22 and 27 appears to fit the corner location, as set. Set a 5/8" X 18" iron rod grouted in concrete on rock, with RLS #19616 cap. Referenced by nails and metal disks in:

6" Spruce	S89W,	13.32'
6" Ironwood	S35E,	22.36'
18" Maple	S74E,	43.73'
8" Maple	N43E,	43.36'