

JOB NUMBER: 95053
SHEET NO. : 1-613

APR 11 1996

LAND CORNER RECORDATION CERTIFICATE

Filing Requirement of Act 74, Mich. P.A. 1970

For corners in

MARQUETTE
(County)

Located In:


Corner Code #

- 1. Public Land Survey T 48N R 25W H-11
 T R
 T R
 T R
- 2. Property Controlling S T R
 in Section S T R
- 3. Miscellaneous S T R
 Property in Section S T R

- 4. Lot No. _____, Recorded Plat _____
- 5. Private Claims _____

MARQUETTE COUNTY
 RECEIVED FOR RECORDING
 1995 DEC 27 AM 7:49
 REGISTER OF DEEDS
 REGISTER OF DEEDS

LIBER 1 PAGE 29
Register of Deeds Stamp & File Number

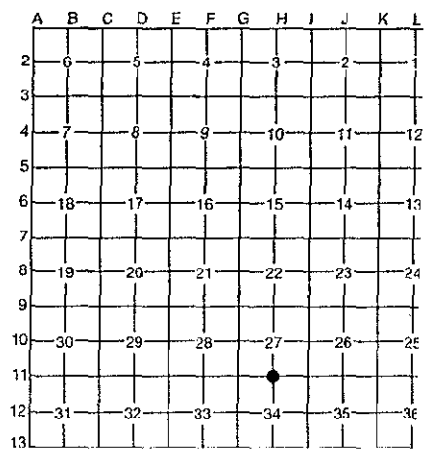

I, GERALD W. CARLSON, in a field survey on Wednesday, October 25, 1995, do hereby certify that under requirements of P.A. 74, Michigan P.A. of 1970, the corner points mentioned in lines 1 and 2 above were in conformance with regulations and rules therefore as required in the current manual of survey instructions of the United States Department of the Interior, Bureau of Land Management or by a decree of a Court of Law and/or that the corner points mentioned in lines 3, 4 and 5 above were in conformance with the rules of the Michigan Board of Professional Surveyors or by a Decree of a Court of Law; established, re-established, monumented, re-monumented, recovered, found as expressed below:

NOTE: Not more than 4 corners, all in the same town and range, may be recorded on this certificate.

A. Description of original monument and accessories and/or subsequent restoration:

H-11: Quarter Corner common to Sections 27 and 34. 1846: No Date: MCRC notes from F.B. #797 indicate the corner at William Ives' original survey notes describe the corner monument as a wood post referenced by:
 6" Dogwood N47W, 07 l
 8" Fir S66E, 13 l
 1911: Charles Cummings, in Record of Surveys Pg. 165, indicates the corner as being 2674' South of the Center 1/4 Corner of Section 27. No accessories given.
 No Date: The corner is indicated on an easement map for Northern Natural Gas Company recorded in L. 72, MR Pg. 587. (See Reverse Side)

No Date: MCRC notes from F.B. #654 (No page given) indicate the corner as a found 3/4" iron pipe on old E/W fence line, C.F. Clark 25836. Referenced by:
 Fd. nail in 6" Maple S70E, 11.37'
 Set 16d nail in 7" Maple S58W, 9.10'
 Set 16d nail in 16" Birch N18W, 9.28'
 Set 16d nail in 10" Birch N27E, 11.00'

B. Description of corner evidence found and/or method applied in restoring or reestablishing corner:

1995: Found and accepted a 3/4" pipe, 0.3' above ground, on W'LY slope as recorded by Charles Clark in L. 4, RC Pg. 243. Distance North is 5312.37', Distance South is 5220.88', Distance East is 2606.90', and Distance West is 2654.53'.

RATIFIED BY PEER GROUP
P.A. 345 OF 1990
Larry J. Bussink
 DATE Oct 23, 1995

C. Description of monument for corner and accessories established to perpetuate locating the position of the corner:

1995: Replaced found 3/4" Pipe with a 2 3/8" O.D. Aluminum Pipe capped with a 3 1/4" Aluminum Tablet Marquette County Survey Monument, 0.2' above ground, and stamped to identify the corner. Found existing references, and replaced overgrown nails with Double Headed Nails in:

7" Maple	S70E,	11.48'	Clark NBT
10" Maple	S62W,	8.97'	Clark NBT
12" Birch	N14W,	9.28'	Clark NBT
10" Birch	N27E,	11.10'	Clark NBT
Set Green Steel Fence Post w/Yellow Survey Marker Sign	S25E,	2.35'	


Note: Existing blazes were repainted, butt blazes added, and stamped B.T. Tags affixed to bearing trees.
 Bk. 11, Pg. 39.

Signed by Gerald W. Carlson

Date 11-13-95

Surveyor's Michigan License No. 24589

FORM APPROVED BY MICHIGAN STATE BOARD OF PROFESSIONAL SURVEYORS, JAN. 28, 1971, REVISED MAY 24, 1978

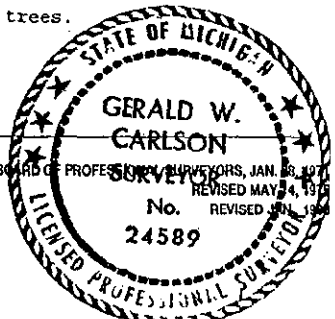

Record No. 613:

*RH
See
Last Page*

Part A Continued:

1983: An LCRC recorded by Charles F. Clark RLS #25836, in L. 4, RC Pg. 243, indicates the corner as a found 3/4" iron pipe on old E-W fence line (Barb-wire, downed) and blazed trees (Marked RLC-ERL; 7-26-77); Nail in 6" Maple S70E 11.37'. Referenced by:

Found nail in 6" Maple	S70E,	11.37'
Set 16d nail in 7" Maple	S58W,	9.10'
Set 16d nail in 12" Birch	N18W,	9.28'
Set 16d nail in 10" Birch	N27E,	11.00'