

**SURVEY &  
REMONUMENTATION**

MARQUETTE COUNTY  
MICHIGAN  
RECEIVED FOR RECORD  
1994 DEC 28 PM 5:55

JOB NUMBER: 94030  
SHEET NO. : 1-451

**APR 28 1995**

**LAND CORNER RECORDATION CERTIFICATE**  
Filing Requirement of Act 74, Mich. P.A. 1970

For corners in

**COMMISSION**

*Patricia A. Monley*  
REGISTER OF DEEDS

_____ MARQUETTE _____ (County)	Located In:	Corner Code #
1. Public Land Survey	T <u>48N</u> R <u>25W</u>	<u>I-11</u>
	T _____ R _____	_____
	T _____ R _____	_____
	T _____ R _____	_____
2. Property Controlling in Section	S _____ T _____ R _____	_____
	S _____ T _____ R _____	_____
3. Miscellaneous Property in Sec.	S _____ T _____ R _____	_____
	S _____ T _____ R _____	_____

LIBER **1** PAGE **124**  
Register of Deeds Stamp & File Number

4. Lot No. \_\_\_\_\_, Recorded Plat \_\_\_\_\_  
5. Private Claims \_\_\_\_\_

I, GERALD W. CARLSON, in a field survey on Monday, November 28, 1994, do hereby certify that under requirements of P.A. 74, Michigan P.A. of 1970, the corner points mentioned in lines 1 and 2 above were in conformance with regulations and rules therefore as required in the current manual of survey instructions of the United States Department of the Interior, Bureau of Land Management or by a decree of a Court of Law and/or that the corner points mentioned in lines 3, 4 and 5 above were in conformance with the rules of the Michigan Board of Land Surveyors or by a Decree of a Court of Law; established, re-established, monumented, re-monumented, recovered, found as expressed below:

A	B	C	D	E	F	G	H	I	J	K	L
2	6		5		4		3		2		1
3											
4	7		8		9		10		11		12
5											
6	18		17		16		15		14		13
7											
8	19		20		21		22		23		24
9											
10	30		29		28		27		26		25
11											
12	31		32		33		34		35		36
13											

**NOTE: Not more than 4 corners, all in the same town and range, may be recorded on this certificate.**

**A. Description of original monument and accessories and/or subsequent restoration:**

I-11: Section Corner common to Sections 26, 27, 34, and 35, T48N-R25W, 1845: William Ives' original survey notes describe the corner monument as a wood post referenced by: 14" Y. Birch N64W, 30 L 8" B. Ash S49E, 23 L 1877: George Cummings field notes indicate an iron at the N.E. Corner of Section 34.	1899: A survey made by George Cummings indicates S.W. Corner of Section 26 as a stone post, 2631.5' West of the south 1/4 Corner of Section 26. Distance North indicated as 2656' with an interior angle of 89-26'. No date given: M.C.R.C. F.B. 797, pg. 63 indicates N.E. Corner of Section 34 as a 1 1/4" iron pipe. No corner accessories given. (See reverse side).
--	---

**B. Description of corner evidence found and/or method applied in restoring or reestablishing corner:**


1994: Found and accepted an iron pipe as referenced above in Part A. Distance South is 2599.44' and Distance North is 2650.23'

CERTIFIED BY PEER GROUP  
P.A. 345 OF 1990  
*Larry J. Beasinger*  
DATE Oct. 17, 1994

**C. Description of monument for corner and accessories established to perpetuate locating the position of the corner:**

1994 - Replaced 2" diameter iron pipe with a 2 1/2" diameter aluminum pipe capped with a 3 1/4" diameter aluminum tablet Marquette County Survey Monument stamped to identify the corner referenced by nails in:  
14" Twin Maple S49W 29.93 ft. Clark NBT  
9" White Birch S29E 47.68 ft. Jamros NBT  
6" Maple N30W 23.67 ft. Jamros NBT  
8" White Birch N36E 59.90 ft. Jamros NBT  
Steel sign post South 1.0 ft.  
Monument is 0.30' above ground.  
Bk. 5, Pg. 51

Signed by *Gerald W. Carlson* Date 12-22-94  
Surveyor's Michigan License No. 24589

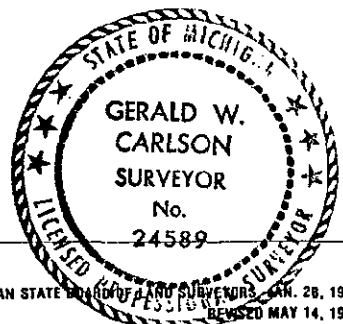

Record No. 451:

*R# 6446  
900  
For Rem*

Part "A" Continued:

1983: Charles Clark R.L.S. 25836 indicates a found 1 1/2" pipe witnessed by three tags - R.L.S. 17618. Referenced by found tags (R.L.S. 17618):

8"	W. Birch	N85E, 49.7'
6"	Tw. Maple	S46W, 30.35'
8"	W. Birch	N40E, 34.15'

L. 4 R.C. Pg. 243

1989: A survey recorded L. 372 R.C. Pg. 439 by Robert F. Cambensy R.L.S. 19616 indicates a found 1 1/2" pipe with nails in R.L.S. 17618 tags in:

9"	W. Birch	N85E, 49.70'
6"	Tw. Maple	S46W, 30.35'
9"	W. Birch	N40E, 34.15'

1993: A Certificate of Survey by Glen Van Neste recorded in Book 002, Pg. 38 indicates a corner at the S.W. Corner of Section 26. No corner accessories given. Distance East is 1313.98' to the West 1/16 Line along the South Line of Section 26.