

JOB NUMBER: 95053  
SHEET NO. : 1-587

APR 01 1996

LAND CORNER RECORDATION CERTIFICATE

Filing Requirement of Act 74, Mich. P.A. 1970

For corners in

COMMISSION

Located In:

Corner Code #


1. Public Land Survey	T 48N	R 25W	J-3
	T	R	
	T	R	
	T	R	
2. Property Controlling in Section	S	T	R
	S	T	R
3. Miscellaneous Property in Section	S	T	R
	S	T	R

REGISTER OF DEEDS  
 MARQUETTE COUNTY  
 RECEIVED FOR RECORD  
 1995 DEC 27 AM 7:47  
 G. W. Carlson  
 REGISTER OF DEEDS

LIBER 1 PAGE 26  
Register of Deeds Stamp & File Number

4. Lot No. \_\_\_\_\_, Recorded Plat \_\_\_\_\_  
 5. Private Claims \_\_\_\_\_

I, GERALD W. CARLSON, in a field survey on Thursday, August 10, 1995, do hereby certify that under requirements of P.A. 74, Michigan P.A. of 1970, the corner points mentioned in lines 1 and 2 above were in conformance with regulations and rules therefore as required in the current manual of survey instructions of the United States Department of the Interior, Bureau of Land Management or by a decree of a Court of Law and/or that the corner points mentioned in lines 3, 4 and 5 above were in conformance with the rules of the Michigan Board of Professional Surveyors or by a Decree of a Court of Law; established, re-established, monumented, re-monumented, recovered, found as expressed below:

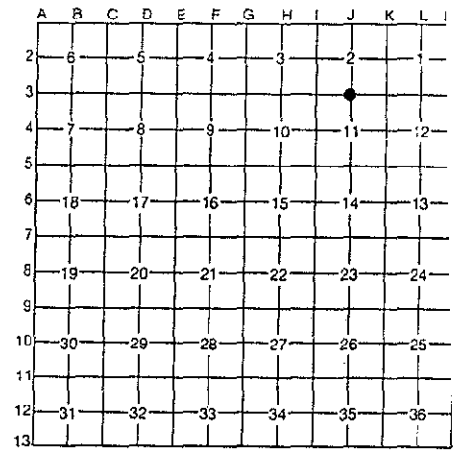

NOTE: Not more than 4 corners, all in the same town and range, may be recorded on this certificate.

A. Description of original monument and accessories and/or subsequent restoration:

<p>J-3: Quarter Corner common to Sections 2 and 11. 1846: William Ives' original survey notes describe the corner monument as a wood post referenced by:          15" Y. Pine N22W, 45 l          6" W. Pine S18E, 47 l          1895: G. Cummings map and notes of Section 11 Rec. in Record of Surveys, Pgs.136-137 indicates the corner to be 2560' East of the SW Corner of Section 2.          1907: L.S.&amp;I Railroad map of the Presque Isle Yard indicates the corner as an iron pipe.</p>	<p>1965+/-: Corner is indicated on various survey maps of the power plant area by R.D. Washburn and John Brotherton no corner accessories available.          1974: R.D. Washburn, RLS#6844, indicates the corner on a survey map of U.P. Generating Company property.          1975: A.C.C.I. survey map based on the 1895 Cummings map indicates the corner to be S89-26'35"E, 2570.54' from the SW Corner of Section 2.          1987: A Land Corner Certificate recorded by Gerald W. Carlson, RLS #24589, in L.5/RC, Pg.151 (see reverse side)</p>
--	---

B. Description of corner evidence found and/or method applied in restoring or reestablishing corner:

1995: Found and accepted a 5/8" iron with RLS cap #24589 as described in Part A above. Distance South is 5335.68', and Distance West is 2570.48'.

RATIFIED BY PEER GROUP :  
P.A. 345 OF 1990


Larry J. Buswell  
DATE OCT. 16, 1995

C. Description of monument for corner and accessories established to perpetuate locating the position of the corner:

1995: Found 5/8" Iron with Cap #24589 drilled and grouted into column base by G. Carlson in 1987. Existing references:  
 N. Face of I Beam S20E, 1.14' Carlson Accessory  
 S. Face of I Beam N02E, 11.95' Carlson Accessory  
 Bldg. Wall N00E, 33.03' Carlson Accessory  
 Bldg. Wall S00E, 3.92' Carlson Accessory  
 Bldg. Wall N90W, 22.92' Carlson Accessory  
 Note: Survey Marker Sign affixed to Web of I Beam 1'+/- South of corner, 5'+/- above ground. Corner is 63.5'+/- West and 112.3'+/- South of the South Stack at the Presque Isle Power Plant.  
 Bk. 8, pg. 152.

Signed by Gerald W. Carlson Date 11-13-95  
 Surveyor's Michigan License No. 24589

FORM APPROVED BY MICHIGAN STATE BOARD OF PROFESSIONAL SURVEYORS, JAN. 1, 1971

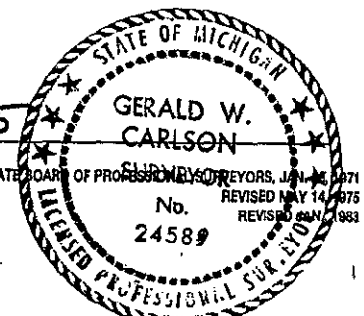

**Record No. 587:**

**Part A Continued:**

indicates that the corner position was calculated from monuments found on Lakeshore Blvd. The position of the corner was such that it had to be destroyed during construction of the power plant. A 5/8" iron with LLS cap #24589 was drilled and grouted into column base and references established:

N. Face of I Beam	S20E,	1.14'
S. Face of I Beam	N02E,	11.95'
Bldg. Wall	N00E,	33.03'
Bldg. Wall	S00E,	3.92'
Bldg. Wall	N90W,	22.92'

No date: Corner is shown on a map recorded in L. 126, MR Pg. 388.

*P#*  
*Geo*  
*Geo*  
*Geo*