

JOB NUMBER: 95053
SHEET NO. : 1-652

APR 1 1996

LAND CORNER RECORDATION CERTIFICATE
Filing Requirement of Act 74, Mich. P.A. 1970

COMMISSION

For corners in

MARQUETTE
(County)

Located In:

Corner Code #

1. Public Land Survey

T48N R27W

M-7

T48N R26W

A-7 ✓

T R

T R

2. Property Controlling
in Section

S T R

S T R

3. Miscellaneous

S T R

Property in Section

S T R

4. Lot No. _____, Recorded Plat _____

5. Private Claims _____

MARQUETTE COUNTY
RECEIVED FOR RECORD
1995 DEC 27 AM 7:49
REGISTER OF DEEDS

LIBER 1 PAGE 297
Register of Deeds Stamp & File Number

A	B	C	D	E	F	G	H	I	J	K	L	M
2	6	5	4	3	2							
3												
4	7	8	9	10	11	12						
5												
6	18	17	16	15	14	13						
7												
8	19	20	21	22	23	24						
9												
10	30	29	28	27	26	25						
11												
12	31	32	33	34	35	36						
13												

I, GERALD W. CARLSON, in a field survey on Monday, December 11, 1995, do hereby certify that under requirements of P.A. 74, Michigan P.A. of 1970, the corner points mentioned in lines 1 and 2 above were in conformance with regulations and rules therefore as required in the current manual of survey instructions of the United States Department of the Interior, Bureau of Land Management or by a decree of a Court of Law and/or that the corner points mentioned in lines 3, 4 and 5 above were in conformance with the rules of the Michigan Board of Professional Surveyors or by a Decree of a Court of Law; established, re-established, monumented, re-monumented, recovered, found as expressed below:

NOTE: Not more than 4 corners, all in the same town and range, may be recorded on this certificate.

A. Description of original monument and accessories and/or subsequent restoration:

M-7: Section Corner common to Sections 13 and 24, T48N-R27W 1973: The corner is shown on a Upper Peninsula Power Company R/W Map recorded in L. 93, MR Pg. 807, and L. 94, and Sections 18 and 19, T48N-R26W. 1844: Austin Burt's original survey notes describe the corner monument as a wood post referenced by:

10" Sugar S62W, 19 1
20" Pine N41W, 34 1

No Date: The corner is shown on a R/W Map from Upper Peninsula Power Company recorded in L. 126, MR Pg. 237.
No Date: MCRC F.B. #654 (No page given) indicates the corner as an Iron Pin. No accessories given.

1987: An LCRC recorded by Larry J. Bussone RLS #25833, in L. 5, RC Pg. 109, indicates no original evidence found. Set a 3/4" Iron, and found old stake and fences to N-S and E-W off corner location. Government calls to West check good with corner location, and 1/4 Corner to North checks

(See Reverse Side)

B. Description of corner evidence found and/or method applied in restoring or reestablishing corner:

1995: Found and accepted a 7/8" diameter Smooth Iron with flattened S'ly edge, 0.40' above ground. Found old fences to N-S & E-W. Distance North is 2625.82' and Distance South is 2629.69'.

RATIFIED BY PEER GROUP
P.A. 345 OF 1990


DATE 12/24/95

C. Description of monument for corner and accessories established to perpetuate locating the position of the corner:

1995: Set a 3 1/4" aluminum tablet Marquette County Survey Monument on found 7/8" smooth iron. Monument is 0.42' above ground and is stamped to identify the corner. Established references using set duplex nails in:

12" W. Birch	N43W,	8.63'	(Bussone N.B.T.)
8" Maple	N62E,	15.98'	
5" Balsam	N83W,	8.90'	(Bussone N.B.T.)
6" Cherry	S68W,	7.88'	(Bussone N.B.T.)
Green Steel Sign Post w/Survey Marker Sign	N06W,	1.85'	

Note: Bearing trees have face and butt blazes, paint, and have B.T. Tags affixed.
Bk. 10, PP. 65-66.

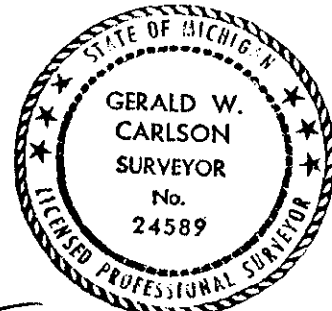

Signed by Gerald W. Carlson

Date 12-20-95

Surveyor's Michigan License No. 24589

Record No. 652:

Part A Continued:

6" Cherry	S60E,	21.2'
5" Cherry	S70W,	7.7'
4" Balsam	N78W,	8.8'
10" W. Birch	N34W,	8.2'

92
12-2-1954