

APR 9 1 1996

JOB NUMBER: 95053
SHEET NO.: 1-653

COMMISSION LAND CORNER RECORDATION CERTIFICATE
Filing Requirement of Act 74, Mich. P.A. 1970

For corners in MARQUETTE Located In: _____ Corner Code # _____
(County)

1. Public Land Survey	T48N	R27W	M-8
	T48N	R26W	A-8
	T	R	
	T	R	
2. Property Controlling in Section	S	T	R
	S	T	R
3. Miscellaneous Property in Section	S	T	R
	S	T	R

MARQUETTE COUNTY
 RECEIVED FOR RECORD
 1995 DEC 27 AM 7:50
 REGISTER OF DEEDS
Daniel L. Mansley

LIBER 1 PAGE 298
Register of Deeds Stamp & File Number

4. Lot No. _____, Recorded Plat _____
 5. Private Claims _____

A	B	C	D	E	F	G	H	I	J	K	L	M
2	6	5	4	3	2							
3												
4	7	8	9	10	11	12						
5												
6	18	17	16	15	14	13						
7												
8	19	20	21	22	23	24						
9												
10	30	29	28	27	26	25						
11												
12	31	32	33	34	35	36						
13												

I, GERALD W. CARLSON, in a field survey on Monday, December 11, 1995, do hereby certify that under requirements of P.A. 74, Michigan P.A. of 1970, the corner points mentioned in lines 1 and 2 above were in conformance with regulations and rules therefore as required in the current manual of survey instructions of the United States Department of the Interior, Bureau of Land Management or by a decree of a Court of Law and/or that the corner points mentioned in lines 3, 4 and 5 above were in conformance with the rules of the Michigan Board of Professional Surveyors or by a Decree of a Court of Law; established, re-established, monumented, re-monumented, recovered, found as expressed below:

NOTE: Not more than 4 corners, all in the same town and range, may be recorded on this certificate.

A. Description of original monument and accessories and/or subsequent restoration:

M-8: Quarter Corner common to Section 24, T48N-R27W and Section 19, T48N-R26W. 1844: Austin Burt's original survey notes describe the corner monument as a wood post referenced by: 10" Maple S75W, 52 l 6" Sugar N57W, 30 l No Date: The corner is shown on a field map for Northern Lands and Timber recorded in L. 106, MR Pg. 720. 1966: The corner is shown on a road sketch to the Negaunee Rod and Gun Club recorded in L. 71, MR Pg. 452.	1987: An LCRC recorded by Larry J. Bussone RLS #25833, in L. 5, RC Pg. 106, indicates no original evidence found. He set a 1" Iron at a point midway between the SW and NW Corners of Section 19, T48N-R26W. Corner hits just West of County Road. Established references: 8" Cherry S57W, 18.6' P. Pole N04E, 53.0' C/L Road Due East, 22.5' 7" Poplar N74E, 50.8'
---	---


B. Description of corner evidence found and/or method applied in restoring or reestablishing corner:

1995: Found and accepted a 1" diameter Re-bar, 0.32' above ground, on West side of North road. Re-bar cut with torch. Distance North is 2629.69' and Distance South is 2530.30'.

RATIFIED BY PEER GROUP
P.A. 345 OF 1990
Larry J. Bussone
DATE 12/04/95

C. Description of monument for corner and accessories established to perpetuate locating the position of the corner:

1995: Set a 2 3/8" O.D. aluminum pipe capped with a 3 1/4" aluminum tablet Marquette County Survey Monument over the top of existing 1" iron. Monument is 0.40' above ground, 22.5' West of C/L road, and stamped to identify the corner. Established references using duplex nails set in:
4" Balsam N36W, 18.13'
5" W. Pine N67W, 23.27'
9" Cherry S55W, 18.93' (Bussone N.B.T.)
7" Balsam S83E, 50.81'
Green Steel Sign Post w/Survey Marker Sign N73W, 1.71'
Note: Bearing trees were face and butt blazed, painted, and had B.T. Tags affixed.
Bk. 10, PP. 63-64.

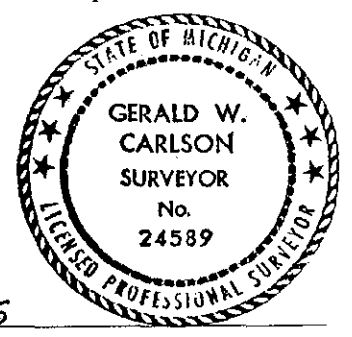

Signed by Gerald W. Carlson Date 12-20-95
Surveyor's Michigan License No. 24589