

MAR 1 2001

MARQUETTE COUNTY MICHIGAN RECEIVED FOR RECORD

1999 NOV 18 PM 2:06

LAND CORNER RECORDATION CERTIFICATE Filing Requirement of Act 74, Mich. P.A. 1970

SECTION

For corners in

MARQUETTE (County)

Located in: Negaunee Township

Corner Code #

- 1. Public Land Survey T48N R26W B-03
2. Property Controlling in Section S T R
3. Miscellaneous Property in Sec. S T R
4. Lot No. , Recorded Plat
5. Private Claims

Patricia A. Monberg REGISTER OF DEEDS

LIBER R2 PAGE 178

Register of Deeds Stamp & File Number

Grid table with columns A-M and rows 1-13. A dot is marked at row 3, column B.

I, George M. Platz, in a field survey on December 7, 1998 do hereby state that under requirements of P.A. 74, Michigan P.A. of 1970, the corner points mentioned in lines 1 and 2 above were in conformance with regulations and rules therefore as required in the current manual of survey instructions of the United States Department of the Interior, Bureau of Land Management or by a decree of a Court of Law and /or that the corner points mentioned in lines 3, 4 and 5 above were in conformance with the rules of the Michigan Board of Land Surveyors or by a Decree of a Court of Law, established, re-established, monumented, recovered, found as expressed below:

NOTE: Not more than 2 corners, all in the same town and range, may be recorded on this certificate.

1/4 corner common to: Section 6 T.48N., R.26W. Section 7 T.48N., R.26W.

A. Description of original monument and accessories and/or subsequent restoration:

1845: Original U.S. Government Survey by Samuel W. Hill - Set wood post witnessed by: S20°E 5 links; 10" White Birch N15°W 10 links; 14" Spruce

1981: Survey computation sheet for section 7 by Sundberg, Carlson & Associates - Calculated point.

1990: Survey computation sheet for section 6 by Van Neste Surveying - Calculated point.

RATIFIED BY PEER GROUP P.A. 345 OF 1990

Signature: Larry J. Busine DATE 12/15/98


B. Description of corner evidence found and/or method applied in restoring or reestablishing corner:

A thorough search found no evidence of any survey monumentation or occupation in the immediate area. No evidence of original B.T.'s could be found. No recorded survey information exists in the Marquette County Register of Deeds concerning this corner. Unrecorded survey information consisting of computation sheets performed by Van Neste Surveying and Sundberg, Carlson & Associates Inc. indicate that no point physically exists at this corner and that any work that has been done by their firms in either sections 6 and 7, has used a mathematical value, based upon single proportionate measurement between adjacent section corners. An original GLO line call to a summit of a Rocky Knob measures as follows to this points calculated location: East 1320' (R) 1350' (M). All measurements, obtainable recorded survey information and any other obtained unrecorded survey information made available to Spalding DeDecker Associates is documented in the research dossier. Considering the above information, we have physically established the 1/4 corner common to section 6 and 7 by single proportionate measurement per GLO notes between adjacent section corners.

C. Description of monument for corner and accessories established to perpetuate locating the position of the corner:

Set standard Marquette County Remonumentation Monument, being a 2 3/8" diameter x 30" aluminum post with 3 1/4" diameter aluminum cap stamped with appropriate corner identification and "1998 PLATZ 38121". Made the following new witnesses:

- Az. 53° 7.77'; Set mag nail w/tag No. 38121 in S.E. face of 12" Spruce.
Az. 100° 4.70'; Set mag nail w/tag No. 38121 in N. Face of 12" Jack Pine.
Az. 230° 16.19'; Set mag nail w/tag No. 38121 in N.W. face of 14" Spruce.
Az. 281° 10.90'; Set mag nail w/tag No. 38121 in N. face of triple 5" Maple.

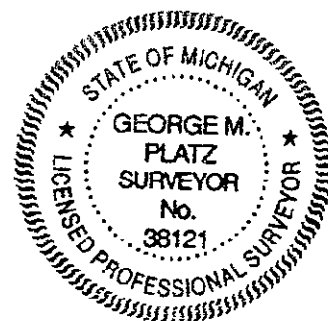

Signed by George M. Platz

Date 12-30-98

Surveyor's Michigan License No. 38121