

**SURVEY &
REMONUMENTATION**

MARQUETTE COUNTY
MICHIGAN
RECEIVED FOR RECORD

JOB NUMBER: 94030
SHEET NO. : 1-513

APR 28 1995

LAND CORNER RECORDATION CERTIFICATE
COMMISSION Filing Requirement of Act 74, Mich. P.A. 1970

1994 DEC 28 PH 5:58

For corners in

Patricia A. Monley
REGISTER OF DEEDS

MARQUETTE (County)	Located In:	Corner Code #
1. Public Land Survey	T 48N R 26W	C-13
	T _____ R _____	_____
	T _____ R _____	_____
	T _____ R _____	_____
2. Property Controlling in Section	S _____ T _____ R _____	_____
	S _____ T _____ R _____	_____
3. Miscellaneous Property in Sec.	S _____ T _____ R _____	_____
	S _____ T _____ R _____	_____

LIBER 1 PAGE 179
Register of Deeds Stamp & File Number

4. Lot No. _____, Recorded Plat _____
5. Private Claims _____

	A	B	C	D	E	F	G	H	I	J	K	L	A
2	6		5		4		3		2		1		
3													
4	7		8		9		10		11		12		
5													
6	18		17		16		15		14		13		
7													
8	19		20		21		22		23		24		
9													
10	30		29		28		27		26		25		
11													
12	31		32		33		34		35		36		
13													

I, GERALD W. CARLSON, in a field survey on Friday, December 16, 1994, do hereby certify that under requirements of P.A. 74, Michigan P.A. of 1970, the corner points mentioned in lines 1 and 2 above were in conformance with regulations and rules therefore as required in the current manual of survey instructions of the United States Department of the Interior, Bureau of Land Management or by a decree of a Court of Law and/or that the corner points mentioned in lines 3, 4 and 5 above were in conformance with the rules of the Michigan Board of Land Surveyors or by a Decree of a Court of Law; established, re-established, monumented, re-monumented, recovered, found as expressed below:

NOTE: Not more than 4 corners, all in the same town and range, may be recorded on this certificate.

A. Description of original monument and accessories and/or subsequent restoration:

C-13: Section Corner, to Sections 31 and 32.	1966: A survey drawing recorded in Liber 282, Page 229 filed
1844: William A. Burt's, original survey notes describe the Corner monument as a wood post referenced by:	R.J. Brotherton, indicates the Section Corner common to 31, 32 and 5 and 6 as an iron. No corner accessories given.
15" Sugar, N83E, 14 l	1986: A Certificate of Survey filed by Larry Bussone, RLS #25833 and recorded in Liber 358, Page 585 indicates the
9" Sugar, N13W, 14 l	Southeast Corner of Section 31 being common with also the
No date given: A map recorded in Liber 278, Page 252 by Ray J. Brotherton indicates the Section Corner common to Sections 31, 32 and 5 and 6 as an iron. No corner accessories given.	Corners for Sections 5 and 6. No corner accessories given. (See reverse side.)

B. Description of corner evidence found and/or method applied in restoring or reestablishing corner:

1994: Found and accepted 1/2" rebar as referenced in Part "A" above. Distance West is 2632.36' and distance East is 2635.84'.


C. Description of monument for corner and accessories established to perpetuate locating the position of the corner:

1994 - Replaced 1/2" iron and cap #30097 with a 2 1/2" diameter aluminum pipe capped with a 3 1/4" diameter aluminum tablet Marquette County Survey Monument stamped to identify the corner referenced by nails in:

- 4" Oak 823E 39.84 ft.
- 4" Poplar N43E 35.57 ft.
- 10" Poplar S21W 13.39 ft. Pierce NBT
- 9" Poplar N84W 13.49 ft. Pierce NBT
- Steel sign post N07W 2.0 ft.
- Monument is 0.4' above ground.
- Bk. 6, Pg. 145

RATIFIED BY PEER GROUP
P.A. 345 OF 1990
Larry J. Bussone
DATE Nov 7, 1994

Signed by *Gerald W. Carlson* Date 12-22-94
Surveyor's Michigan License No. 24589

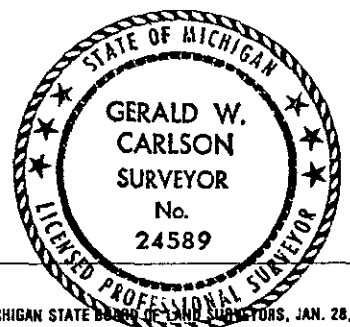

Record No. 513:

Part "A" Continued:

1989: A Land Corner Recordation Certificate filed by Al Pierce, RLS #30097, indicates a capped 1/2" rebar established by utilization of C.C.I.C. furnished coordinates. Referenced to the 1/4 Corner common of Sections 31 and 6 being 35.45N and 2632.10 West. Referenced by:

- 4" Poplar, N38E, 35.66'
- 10" Poplar, S21W, 13.39'
- 8" Cherry, S78E, 3.77'
- 9" Poplar, N84W, 13.49'

Liber 5RC, Page 226. The recorded Land Corner Recordation Certificate makes reference to Corner C1, T47N-R26W which is incorrect.

*RLS 6446
900
2-22-89*