

MAR 19 1999

LAND CORNER RECORDATION CERTIFICATE  
Filing Requirement of Act 74, Mich. P.A. 1970

MARQUETTE COUNTY  
MICHIGAN  
RECEIVED FOR RECORD

1999 FEB 12 PM 3:33

*Richard A. Monroy*  
REGISTER OF DEEDS

For corners in SECTION

<u>MARQUETTE</u> (County)	Located In: Negaunee Township	Corner Code #
1. Public Land Survey	T <u>48N</u> R <u>R26W</u>	<u>E-03</u>
	T _____ R _____	_____
	T _____ R _____	_____
	T _____ R _____	_____
2. Property Controlling in Section	S _____ T _____ R _____	_____
	S _____ T _____ R _____	_____
3. Miscellaneous Property in Sec.	S _____ T _____ R _____	_____
	S _____ T _____ R _____	_____

LIBER **R2** PAGE **143**  
Register of Deeds Stamp & File Number

4. Lot No. \_\_\_\_\_, Recorded Plat \_\_\_\_\_  
5. Private Claims \_\_\_\_\_

George M. Platz, in a field survey on December 7, 1998 do hereby state that under requirements of P.A. 74, Michigan P.A. of 1970, the corner points mentioned in lines 1 and 2 above were in conformance with regulations and rules therefore as required in the current manual of survey instructions of the United States Department of the Interior, Bureau of Land Management or by a decree of a Court of Law and/or that the corner points mentioned in lines 3, 4 and 5 above were in conformance with the rules of the Michigan Board of Land Surveyors or by a Decree of a Court of Law; established, re-established, monumented, recovered, found as expressed below:

	A	B	C	D	E	F	G	H	I	J	K	L	M
1													
2	6			5		4		3		2		1	
3					●								
4	7			8		9		10		11		12	
5													
6	18			17		16		15		14		13	
7													
8	19			20		21		22		23		24	
9													
10	30			29		28		27		26		25	
11													
12	31			32		33		34		35		36	
13													

NOTE: Not more than 2 corners, all in the same town and range, may be recorded on this certificate.

Section corner common to: Section 4 T.48N., R26W.  
Section 5 T.48N., R26W.  
Section 8 T.48N., R26W.  
Section 9 T.48N., R26W.

A. Description of original monument and accessories and/or subsequent restoration:

1845: Original U.S. Government Survey by Samuel W. Hill - Set wood post witnessed by:  
N40°E 8 Links; 18" W. Birch  
S28°W 35 Links; 10" Sugar

RATIFIED BY PEER GROUP  
P.A. 345 OF 1990

*Larry J. Bussone*  
DATE 12/15/98

1916 -1918: Section corner coordinate information from Cleveland Cliffs Iron Company indicates the corner to be a "standard" brass capped monument. No additional information given.

1949: U.S. Steel Corporation - Found iron pipe from remaining witnesses.

1981: L.C.R.C. Recorded in L.4 of R.C., P.122 Marquette County Records. Robert Schmeling P.S. No.8317 - Found 1 1/2" diameter iron pipe with "standard" brass cap, 18"+/- above the ground. Stamped "MEAD", "RLS 8317" and "1981" on cap.

N26°E 40.9'; nail in E of 8" White Spruce  
N28°E 30.4'; nail in E of 10" White Spruce  
S26°W 37.2'; nail in E of 9" White Spruce  
N88°W 30.3'; nail in E of 16" White Spruce

1992: Survey computation sheet by Larry Bussone, PS 25833. No description or witnesses given.

1993: Survey (unrecorded) Glen Van Neste, PS 27464. Found iron pipe with 4" brass disk. No witnesses given.

B. Description of corner evidence found and/or method applied in restoring or reestablishing corner:

Found 1 1/2" diameter galvanized iron pipe with brass cap 18"+/- above ground, stamped with appropriate identification as described in L.C.R.C. recorded in L.4 of R.C., P.122 Marquette County Records. A thorough search found no evidence of any other survey monumentation or occupation in the immediate area. No evidence of original BT's could be found. The position of the corner has been used and accepted by others as evidenced by line markings and surveys done by others. All measurements, obtainable recorded survey information and any other obtained unrecorded survey information made available to Spalding DeDecker Associates is documented in the research dossier. Considering the above information, all known evidence favors the correctness of this point.


C. Description of monument for corner and accessories established to perpetuate locating the position of the corner:

Accepted found 1 1/2" diameter galvanized iron pipe and brass cap stamped with appropriate identification. Stamped "MCR 1998," on brass cap to properly identify accepted corner. Made the following witnesses:

Az. 28° 40.75' Set mag nail w/tag No.38121 in W. face of a 12" White Spruce  
Az. 174° 24.25' Set mag nail w/tag No.38121 in E. face of a 12" Birch  
Az. 209° 37.22' Set mag nail w/tag No.38121 in S.E. face of a 12" White Spruce  
Az. 280° 30.30' Set mag nail w/tag No.38121 in N. face of a 24" White Spruce with B.T. tag aff.

Signed by George M. Platz

Date 12-30-98  
No. 38121

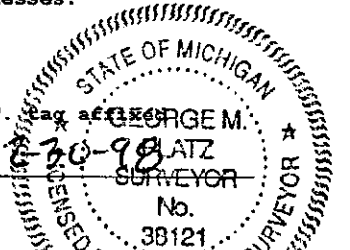

Surveyor's Michigan License No. 38121