5. Private Claims

11111 12版。

## LAND CORNER RECORDATION CERTIFICATE

MARQUETTE	COUNTY
RECEIVED FO	AN R RECORD

For corners in SECTION	In I	1934 NOV 18 PM 2:06
MARQUETTE (County)	Located In: Corner Code #  Negaunse Township	Patricia d. Monley REGISTER OF DEEDS
1. Public Land Survey	T <u>48N</u> R <u>26W                                    </u>	REGISTER OF DEEDS
Property Controlling     in Section     Miscellaneous     Property in Sec.	S T R S T R S T R	Register of Deeds Stamp & File Number
4. Lot No, Reco	rded Plat	

George M. Platz in a field survey on December 7 , 19 98 do hereby state that under requirements of P.A. 74, Michigan P.A. of 1970, the corner points mentioned in lines 1 and 2 above were in conformance with regulations and rules therefore as required in the current manual of survey instructions of the United States Department of the Interior, Bureau of Land Management or by a decree of a Court of Law and /or that the corner points mentioned in lines 3, 4 and 5 above were in conformance with the rules of the Michigan Board of Land Surveyors or by a Decree of a Court of Law; established, re-established, monumented, recovered, found as expressed below:

NOTE: Not more than 2 corners, all in the same town and range, may be recorded on this certificate.

1/4 Corner common to: Section 8 T.48N., R.26W. Section 9 T.48N., R.26W.

4 5 6 8 9 11

A. Description of original monument and accessories and/or subsequent restoration:

1845: Original US Government Survey by Samuel W. Hill - Set wood post witnessed by:

N30°E

18 links; 18" Y. Birch 26 links; 8" Fir S55°W

345 OF 1990

RATIFIED BY PEER GROUP

1992: Survey computation sheet by Larry Bussone, PS 25833, which indicates he set a point (undescribed), by single proportionate measurement between the SW and NW corners of section 9. No witnesses given.

1993: Survey (unrecorded) by Glen Van Neste, PS 27464, which indicates that he set a 5/8" iron rod w/cap using a combination of his own field work and coordinate information supplied by Larry Bussone, PS 25833. Said point was to be on line and half way between the SE and NE corners of section 8.

B. Description of corner evidence found and/or method applied in restoring or reestablishing corner:


Found iron rod with cap no.25633, 3.72' N and 2.77' W of the intended position per Bussone computation sheet. Also found iron rod with cap no.27464, 39.45' N and 18.83' W of the intended position per Van Neste Survey. After discussions with both Bussone and Van Neste, it was determined that their respective points were not representative of the true position as originally intended by both parties. An original GO line call concerning a "summit of hill" southerly from this point is not distinct in the field but does satisfactory fit a single proportionate calculated location between adjacent section corners. No evidence of original B.T.'s could be found. No other recorded or unrecorded information concerning this corner is known to Spalding DeDecker Associates. Considering the above information, we have physically established the 1/4 corner common to sections 8 and 9 by single proportionate measurement, per GO notes, between adjacent section corners. The existing points have been removed.

C. Description of monument for corner and accessories established to perpetuate locating the position of the corner:

Set standard Marquette County Remonumentation Monument, being a 2 3/8" diameter x 30" aluminum post with 3 1/4" diameter aluminum cap stamped with appropriate corner identification and "1998 FLATZ 38121". Made the following new witnesses:

Az. 86° Az. 170° Az. 230°

346°

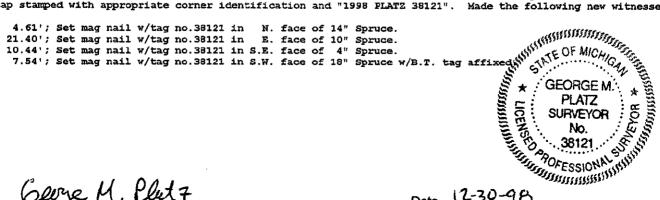

George M. Plat 7

Date 12-30-98

Surveyor's Michigan License No. 38121

457