

MAY 2 2 1997

COMMISSION

LAND CORNER RECORDATION CERTIFICATE

MARQUETTE COUNTY
MICHIGAN
RECEIVED FOR REPORT

1004 DEC 20 PM 2: 12

• •	Filing Requiren	ent of Act 74, Mich. P./	A. 1970
For corners in MARQUETTE (County)	Located in:	Corner Code #	Patricia d. Monley REGISTER OF DEFOS 9
1. Public Land Survey	T 48N R 26W T R R T R	F-9	
2. Property Controlling S in Section S 3. Miscellaneous S Property in Sec. S	TR TR TR		LIBER 1 PAGE 352 Register of Deeds Stamp & File Number
4. Lot No, Recorded P 5. Private Claims	at		
i, GERALD W. CARLSON, in do hereby state that under requirements mentioned in lines 1 and 2 above were required in the current manual of survey in Bureau of Land Management or by a dimentioned in lines 3, 4 and 5 above were Land Surveyors or by a Decree of a Circovered, found as expressed below: NOTE: Not more than 2 corners, all on this certificate. A. Description of original monument	of P.A. 74, Michigan P. in conformance with reg structions of the United Structions of a Court of Law in conformance with the court of Law; established in the same town and r	A. of 1970, the comer point ulations and rules therefore tates Department of the Interior and/or that the corner point rules of the Michigan Board, re-established, monumented ange, may be recorded	1 2 6 -5 4 -3 -2 -1 nts 4 -7 -8 9 -10 -11 -12 as 5 or, ats 6 -18 -17 -16 -15 -14 -13 of 7
F-9: <u>Quarter Corner common to Sectio</u> 1845: Sam U. Hill's original subdivisio wood post referenced by: 18" Sugar S08W, 80 L No Date: A map of the Proposed Nega	ns 21 and 28, n survey notes describe 14" Sugar unee Airport (Source ur	the corner monument as N18W, 30 L	DATE 12/16/96
as an old Iron Monument, and shows a 28; Distance SOO-08'W, 2558.4' to the Corner of Section 21. No accessories	ie Center 1/4 Corner of	om the corner. Distance I Section 28; and Distance	N87-25'E, 2635.2' to the N.E. Corner of Section N00-19'W, 1332.4' to the Center-South 1/16

1910: A Survey Map of Section 28 by R.A. Brotherton for C.C.I. Co. indicates a set Iron at the corner. Distance South, 2564.34' to the Center 1/4 Corner of Section 28. No accessories given.

1910: A sketch of Section 28 by R.A. Brotherton for C.C.I. Co. indicates the corner as having been previously set, Distance East, 2638.8' to the N.E. Corner of Section 28. Distance South, 2564.34' to an Iron set by R.A. Brotherton at the Center 1/4 Corner of Section 28. No accessories given. (SEE REVERSE SIDE)

Description of corner evidence found and/or method applied in restoring or reestablishing corner: F-9: 1996: Searched and found no original or subsequent corner evidence. Obtained coordinate values of this corner and the corners 1/2 mile East, West, and South from Larry Bussone, P.S. #25833, who tied in these corners by traverse some years ago. The corners 1/2 mile East, West, and South are still in existence, and the Distances checked well with those by Bussone. We used our Star-Net adjustment program to obtain a "best fit" location of this corner from the other three known corners. The final distances checked very well with those previously determined by Bussone. Distance East is 2635.67' and Distance West is 2656.13'.

C. Description of monument for corner and accessories established to perpetuate locating the position of the corner: F-9: 1996: Set a 2 3/8" O.D. aluminum pipe capped with a 3 1/4" diameter aluminum tablet Marquette County Survey Monument stamped to identify the corner. Monument is 0.6' below ground. Referenced by:

S.E.'LY Fence Corner N.W. Corner Black Sign #3

Due North, 259.341 S36W, 274.63'

Tenth Fence Post West of S.E.'LY Fence Corner

N20W. 271.15

Green Steel Sign Post w/ Yellow Survey Marker Sign

Runway Light #49

Bk.9, pp. 103-106

Due North, 2.0'

\$30W, 274.101




Tend a Carlso


JUL 0 3 2000

<u>F-9:</u>

SECTION

PART A CONTINUED:

 

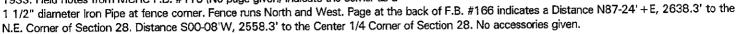

No Date: Field notes from MCRC F.B. #701 (No page given) indicate the corner as a 1" Iron Pipe at fence intersection. No accessories given.

1941: A Field Map of Section 21 by R.A. Brotherton for C.C.I. Co. indicates the corner as an Iron. No accessories given.

1968: A sketch of Section 28 from the personal notes of R.A. Brotherton, as copied in 1968 by R.J. Brotherton, indicate the corner as an Iron - B.T. on Pine. Distance East, 2639.47' to the N.E. Corner of Section 28; Distance West, 2674.0' to the N.W. Corner of Section 28; and Distance South, 2564.34' to the Center 1/4 Corner of Section 28. No accessories given.

1978: Survey field notes from C.C.I. indicate they tied into a found Iron at the North 1/4 Corner of Section 28. Distance S88-22'-34"W, 2656.00'to the N.W. Corner of Section 28, and N87-15'-14"E, 2635.46' to the N.E. Corner of Section 28. No accessories given.

Jag Con