

JUL 03 2000

MARQUETTE COUNTY MICHIGAN RECEIVED FOR RECORD

1996 DEC 20 PM 2:13

SECTION

LAND CORNER RECORDATION CERTIFICATE Filing Requirement of Act 74, Mich. P.A. 1970

Patricia A. Mackay REGISTER OF DEEDS pm

For corners in MARQUETTE (County) Located In: Corner Code # 1. Public Land Survey T 48N R 26W H-11 2. Property Controlling in Section S T R 3. Miscellaneous Property in Sec. S T R 4. Lot No. , Recorded Plat 5. Private Claims

LIBER R1 PAGE 359 Register of Deeds Stamp & File Number

I, GERALD W. CARLSON, in a field survey on OCTOBER 10TH, 19 96, do hereby state that under requirements of P.A. 74, Michigan P.A. of 1970, the corner points mentioned in lines 1 and 2 above were in conformance with regulations and rules therefore as required in the current manual of survey instructions of the United States Department of the Interior, Bureau of Land Management or by a decree of a Court of Law and/or that the corner points mentioned in lines 3, 4 and 5 above were in conformance with the rules of the Michigan Board of Land Surveyors or by a Decree of a Court of Law; established, re-established, monumented, recovered, found as expressed below:

Grid table with columns A-L and rows 1-13. A dot is marked at the intersection of column H and row 11.

NOTE: Not more than 2 corners, all in the same town and range, may be recorded on this certificate.

A. Description of original monument and accessories and/or subsequent restoration:

H-11: Quarter Corner common to Sections 27 and 34. 1845: Sam U. Hill's original subdivision survey notes describe the corner monument as a wood post referenced by: 10" Maple N08W, 43 L 20" Birch S58E, 49 L

RATIFIED BY PEER GROUP P.A. 345 OF 1990

Larry J. Bussone DATE 12/16/96

No Date: The corner is shown on an unidentified map of Section 27. Distance East 2628' to the S.E. Corner of Section 27; Distance West of 2628' to the S.W. Corner of Section 27; Distance North 2632' to the Center 1/4 Corner of Section 27. No accessories given.

No Date: The corner is shown on an unidentified map of Section 34. Distance East, 2629' to the N.E. Corner of Section 34; Distance West, 2629' to the N.W. Corner of Section 34. No accessories given.

1920: The corner is shown as an Iron set from B.T. Pine Stump on a field Map of Section 34 by R.A. Brotherton for C.C.I. Co. . Distance East, 2628' to the S.E. Corner of Section 27; Distance West, 2628' to the S.W. Corner of Section 27; Distance North, 2632' to the Center 1/4 Corner of Section 27. No accessories given.

No Date: An unidentified map of Section 27 indicates a B.T. at the corner, along with a road passing by just West of the corner, and N-S and E-W fences running from a fence corner at the corner location. No accessories given.

1983: A Certificate of Survey by Robert F. Cambensy P.S. #19616, indicates the corner as a set 5/8" X 48" Iron Rod on the North edge of an East-West dirt road, 45' East of a North-South dirt road. Distance N89-29'-04"W, 2623.59' to a found 3/4" iron bar at the S.W. Corner of Section 27. Distance N00-07'-03"E, 2628.36' to a found 1" solid iron axle at the Center Quarter Corner of Section 27. Distance S89-27-48"E, 2625.87' to a found 1" iron pin at the S.E. Corner of Section 27. No liber or page given. Referenced by: 20" W.Pine S38E, 14.91' (Nail & Disk) 12" Oak N32W, 28.22' (Nail & Disk) 9" Trip. W. Birch S72W, 51.40' (Nail & Disk, N. Trunk)

B. Description of corner evidence found and/or method applied in restoring or reestablishing corner:


H-11: 1996: No original evidence found. Found and accepted a 5/8" Iron with RLS cap #19616, 0.2' below ground in North rut of a two-track road, and on line with an old N-S fence to the North. There were no distinctive Line Calls to check near corner. Distance East is 2625.72' and Distance West is 2622.56'.

C. Description of monument for corner and accessories established to perpetuate locating the position of the corner:

H-11: 1996: Set a 2 3/8" O.D. aluminum pipe over top of existing 5/8" Iron, and capped it with a 3 1/4" diameter aluminum tablet Marquette County Survey Monument stamped to identify the corner. Monument is 0.4' below ground. Set d.h. nails underneath found nails w/ brass washers in references with found painted face and nail blazes:

6" Trip. W. Birch S73W, 51.41' (Cambensy NBT) 8" Oak N32W, 28.18' (Cambensy NBT) 15" W. Pine S35E, 14.93' (Cambensy NBT) Established new reference: 4" W. Pine N42E, 31.65' Green Steel Sign Post w/ Yellow Survey Marker Sign North, 7.40'

Note: Bearing trees have painted face, butt, and side nail blazes, d.h. measuring nails, and stamped B.T. Tags affixed. Bk. 10, Pg. 107.

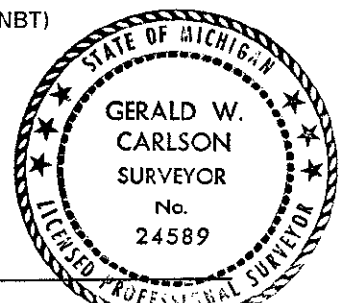

Signed by Gerald W. Carlson Date 12-19-96

Surveyor's Michigan License No. 24589