

MAY 22 1997

COMMISSION

LAND CORNER RECORDATION CERTIFICATE
Filing Requirement of Act 74, Mich. P.A. 1970

MARQUETTE COUNTY MICHIGAN RECEIVED FOR RECORD

1996 DEC 20 PM 2: 1

Handwritten signature: Patricia A. Mander, REGISTER OF DEEDS

Form for recording corners with fields for 'For corners in MARQUETTE (County)', 'Located In: T 48N R 26W', 'Corner Code # 1-9', and numbered sections 1-5.

LIBER 1 PAGE 360 Register of Deeds Stamp & File Number

I, GERALD W. CARLSON, in a field survey on October 7TH, 19 96, do hereby state that under requirements of P.A. 74, Michigan P.A. of 1970, the corner points mentioned in lines 1 and 2 above were in conformance with regulations and rules therefore as required in the current manual of survey instructions of the United States Department of the Interior, Bureau of Land Management or by a decree of a Court of Law and/or that the corner points mentioned in lines 3, 4 and 5 above were in conformance with the rules of the Michigan Board of Land Surveyors or by a Decree of a Court of Law; established, re-established, monumented, recovered, found as expressed below:

NOTE: Not more than 2 corners, all in the same town and range, may be recorded on this certificate.

A. Description of original monument and accessories and/or subsequent restoration: I-9: Section Corner common to Sections 22, 23, 26, and 27.

1845: Sam U. Hill's original subdivision survey notes describe the corner monument as a wood post referenced by: 14" W. Pine S68E, 12 L 10" Cedar S70W, 19 L

No Date: The corner is shown on a survey map by R.A. Brotherton P.S. #47, recorded in L. 312, Deeds Pg. 52; and L. 352, Deeds Pg. 363.. No accessories given.

No Date: The corner is shown on a map recorded in L. 287, Deeds Pg. 452. No accessories given.

No Date: The corner is shown on a map recorded in L. 287, Deeds Pg. 296. Distance West, 2640' to an Iron at the South 1/4 Corner Section 22. No accessories given. (SEE REVERSE SIDE)

B. Description of corner evidence found and/or method applied in restoring or reestablishing corner: I-9: 1996: No original evidence found. Found and accepted a 1" O.D. Iron Pipe with a 3/4" nut at top, 3' long, and projecting 1.3' high in a large pile of rocks. Corner is +/- 190' North of a concrete R/W marker near the toe of the North slope of U.S. 41 West. Corner is on the rocky Westerly slope of a knob, +/- 25' West of top of slope, and +/- 30' North of a conspicuous 7' high rock outcrop projecting to the West. Distances and bearings to found references check very well with those recorded by G. Carlson in 1980. Checked Line Call: East, 3.00 chains (198') to base of knob of rock. Measured Call: East, 201', intersected South Base of a rock knob to the North. Checked Line Call: North, 1.50 chains (99'), Leave knob. Measured Call: North, 98', to top of a 15' high cliff at North end of knob. Distance East is 2652.45', Distance West is 2628.25', and Distance South is 2591.41'.


C. Description of monument for corner and accessories established to perpetuate locating the position of the corner: I-9: 1996: Replaced found 1" Iron Pipe with a 3/4" X 24" Iron driven into crack at bottom of a found +/- 1' deep hole filled with rocks. Secured Iron in place with concrete and rocks and capped it with a 3 1/4" diameter aluminum tablet Marquette County Survey Monument stamped to identify the corner. Monument is 0.6' above ground, and is surrounded by piled rocks painted orange. Set d.h. nails in existing references:

10" Tw. Oak N16E, 15.85' (Carlson NBT) 6" Maple S38W, 8.65' (Carlson NBT)
Established references:
5" W. Birch S65E, 12.82' (Set d.h. nail N. side, 1' high) 4" Maple N43W, 19.58' (Set d.h. nail S.W. side, 2' high)
Set Green Steel Sign Post w/ Yellow Survey Marker Sign N63W, 10.58'

Note: Bearing trees have painted face, butt, and side nail blazes, d.h. measuring nails, and stamped B.T. Tags affixed. Distance to 10" Tw. Oak is to d.h. nail set directly above a chopped out nail/washer, W. side, 1.5' high. Distance to 6" Maple is to d.h. nail set at magnetic dip in old healed-over notch, E. side, 2' high. Bk.11, pp.137-138.

Signed by Gerald W. Carlson Date 12-19-96

Surveyor's Michigan License No. 24589

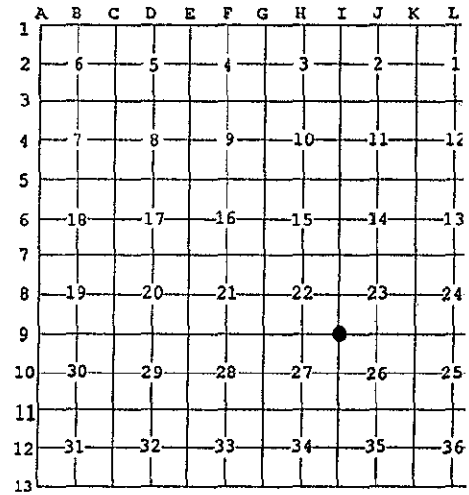

JUL 03 2000

I-9:
PART A CONTINUED:

SECTION

Q# 9798
Geo
Geo Rem

No Date: The corner is shown as an Iron (and B.T.) on a map recorded in L. 284, Deeds Pg. 469. No accessories given.

No Date: The corner is shown on a map by R.A. Brotherton, C.E., recorded in L. 280, Deeds Pg. 38. No accessories given.

No Date: A corner is shown as an Iron Set From B.T. on a field map of Section 27 by R.A. Brotherton for C.C.I. Co. No accessories given.

No Date: The corner is shown as an Iron on a field map of Section 23 by R.A. Brotherton. Distance East, 2666.4' to a Stake at the South 1/4 Corner of Section 23. No accessories given.

No Date: The corner is indicated on MSHD highway plans (Proj. No. 52-40) recorded in L. 211, Deeds Pg. 387. . Distance S00-56'-14"E, 287.96' to C/L U.S. 41 and M-28. No accessories given.

No Date: The corner is shown as an Iron Set From B.T. on a map of the S.W. 1/4 of Section 23 by R.A. Brotherton. No accessories given.

1935: The corner is shown as an Iron Pin on a field map of Section 22 by R.A. Brotherton for C.C.I. Co.. Distance West, 2640' to the South 1/4 Corner of Section 22. No accessories given.

1954: The corner is shown as an Iron on a field map of Section 26 by R.A. Brotherton for C.C.I. Co.. No accessories given.

1971: The corner is shown as a 1" Iron Bolt on a map by R.J. Brotherton recorded in L. 288, Deeds Pg. 265. No accessories given.

1978: A Certificate of Survey recorded by Gerald W. Carlson P.S. #24589, in L. 1, SM Pg. 251, indicates the corner as a Found 1" Diam. Iron w/Nut. Distance S00-57'-45"E, 2591.63' to the East 1/4 Corner of Section 27. Found 1" Iron w/Nut referenced by:

4" Maple S35W, 08.67'	2" Maple N56W, 09.27'
8" Tw. Oak N16E, 15.86'	8" W. Birch S73E, 16.19'

1978: An LCRC recorded by Gerald W. Carlson P.S. #24589, in L. 1, RC Pg. 286, indicates the corner as a found 1" Dia. Iron W/Nut @ 1' high, near crest of rock bluff @ 300' North of U.S. 41 orange guard rail post marking Line N-S. Referenced by:

4" Maple S35W, 08.67'	2" Maple N56W, 09.27'
8" Tw. Oak N16E, 15.86'	8" W. Birch S73E, 16.19'

The corner is shown on a survey map recorded by G. Salminen P.S. #11369, in L. 327, Deeds Pg. 318. No accessories given.

1980: The corner is shown on a MSHD Right of Way Map from File # 52-R-1, Sheet 16. No accessories given.

1980: A Certificate of Survey recorded by Gerald W. Carlson P.S. #24589, in L. 1, SM Pg. 368, indicates the corner as a Found 1" Diam. Iron w/Nut referenced by:

4" Maple S35W, 08.67'	2" Maple N56W, 09.27'
8" Tw. Oak N16E, 15.86'	8" W. Birch S73E, 16.19'

1985: The corner is indicated on a Property Description Map by Gerald W. Carlson P.S. #24589, and recorded in L. 365, Deeds Pg. 619. No accessories given.

1986: The corner is indicated on a Property Description Map by Gerald W. Carlson PS #24589, recorded in L. 358, Deeds Pg. 153; L. 375, Deeds pp. 452 and 454; and L. 129, MR Pg. 557. Distance S00-57'-45"E, 1295.81' to the E.N.E. 1/16 Corner of Section 27. No accessories given.

1993: A Certificate of Survey recorded by Alan K. Pierce P.S. #30097, in L. 2, SM Pg. 55, indicates the corner as a found 1" Iron With Nut. Distance N00-54'-16"E, 1336.72' to the South 1/16 Corner common to Sections 22 and 23. No accessories given.