

APR 28 1995

MARQUETTE COUNTY  
MICHIGAN  
RECEIVED FOR RECORD

1994 DEC 28 PM 5:59

JOB NUMBER: 94030  
SHEET NO. : 1-531

**COMMISSION LAND CORNER RECORDATION CERTIFICATE**  
**Filing Requirement of Act 74, Mich. P.A. 1970**

For corners in

MARQUETTE (County)	Located In:	Corner Code #
1. Public Land Survey	T 48N R 26W	L13
	T _____ R _____	_____
	T _____ R _____	_____
	T _____ R _____	_____
2. Property Controlling in Section	S _____ T _____ R _____	_____
	S _____ T _____ R _____	_____
3. Miscellaneous Property in Sec.	S _____ T _____ R _____	_____
	S _____ T _____ R _____	_____

*Patricia A. Monbey*  
REGISTER OF DEEDS

LIBER 1 PAGE 197  
Register of Deeds Stamp & File Number

- 4. Lot No. \_\_\_\_\_, Recorded Plat \_\_\_\_\_
- 5. Private Claims \_\_\_\_\_

I, GERALD W. CARLSON, in a field survey on Thursday, December 15, 1994, do hereby certify that under requirements of P.A. 74, Michigan P.A. of 1970, the corner points mentioned in lines 1 and 2 above were in conformance with regulations and rules therefore as required in the current manual of survey instructions of the United States Department of the Interior, Bureau of Land Management or by a decree of a Court of Law and/or that the corner points mentioned in lines 3, 4 and 5 above were in conformance with the rules of the Michigan Board of Land Surveyors or by a Decree of a Court of Law; established, re-established, monumented, re-monumented, recovered, found as expressed below:

	A	B	C	D	E	F	G	H	I	J	K	L	M
2	6	5	4	3	2	1							
3													
4	7	8	9	10	11	12							
5													
6	18	17	16	15	14	13							
7													
8	19	20	21	22	23	24							
9													
10	30	29	28	27	26	25							
11													
12	31	32	33	34	35	36							
13													

**NOTE: Not more than 4 corners, all in the same town and range, may be recorded on this certificate.**

**A. Description of original monument and accessories and/or subsequent restoration:**

L-13: South 1/4 Corner Section 36, T48N-R26W.  
1844: William A. Burt's original survey notes described the corner monument as a sugar post, referenced by:  
11" Sugar, N84E, 60 l  
14" Sugar, N60W, 9 l

**B. Description of corner evidence found and/or method applied in restoring or reestablishing corner:**


1994: Found and accepted a 1 1/4" iron pipe. Distance West is 2632.85' and distance East is 2637.97'. North 1/4 Corner Section 1, T47N-R26W is West 16.58'

**RATIFIED BY PEER GROUP  
P.A. 345 OF 1990**

*Larry J. Buswell*  
DATE Nov 7, 1994

**C. Description of monument for corner and accessories established to perpetuate locating the position of the corner:**

1994 - Replaced 1 1/4" diameter iron pipe with a 5/8" iron rod capped with a 3 1/4" diameter aluminum tablet Marquette County Survey Monument stamped to identify the corner referenced by nails in:  
7" Oak S14E 21.11 ft.  
4" Oak N84W 8.44 ft.  
9" Birch N01W 13.71 ft. (existing blaze and scribing)  
9" Oak S71E 12.14 ft. (existing blaze and scribing)  
Steel sign post N20E 2.4 ft.  
Monument is 0.5' above ground.  
Bk. 6, Pg. 143

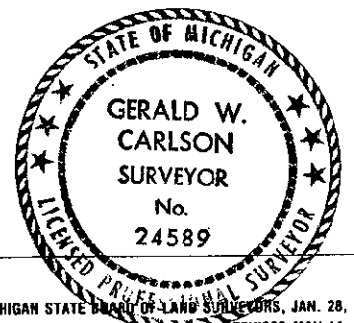

Signed by Gerald W. Carlson Date 12-22-94

Surveyor's Michigan License No. 24589