

1993

COMMISSION

MARQUETTE COUNTY MICHIGAN RECEIVED FOR RECORD

JOB NUMBER: 93300 SHEET NO. : 1-328

LAND CORNER RECORDATION CERTIFICATE 1993 DEC 22 PM 4:12 Filing Requirement of Act 74, Mich. P.A. 1970

For corners in

Table with columns: MARQUETTE (County), Located In: (Town/Range), Corner Code #. Includes entries for Public Land Survey and Property Controlling in Section.


Handwritten signature and stamp: Registered Professional Surveyor

Liber 1. R.C. Page 31.

Register of Deeds Stamp & File Number

4. Lot No. , Recorded Plat Private Claims

I, GERALD W. CARLSON, in a field survey on Tuesday, November 30, 1993, do hereby certify that under requirements of P.A. 74, Michigan P.A. of 1970, the corner points mentioned in lines 1 and 2 above were in conformance with regulations and rules therefore as required in the current manual of survey instructions of the United States Department of the Interior, Bureau of Land Management or by a decree of a Court of Law and/or that the corner points mentioned in lines 3, 4 and 5 above were in conformance with the rules of the Michigan Board of Land Surveyors or by a Decree of a Court of Law; established, re-established, monumented, re-monumented, recovered, found as expressed below:

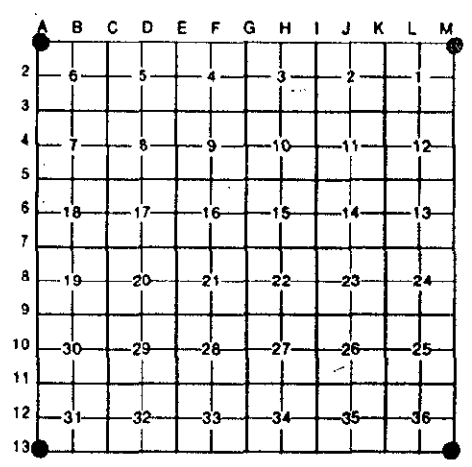

NOTE: Not more than 4 corners, all in the same town and range, may be recorded on this certificate.

A. Description of original monument and accessories and/or subsequent restoration:

A-13: Section Corner common to Section 6, T48N-R25W; Section 1988 - G. Carlson found and iron with LS cap #15413 and 31, T49N-R25W; Section 1, T48N-R26W; Section 36, T49N-26W. #25836 referenced by: 1845: William A. Burt's original survey notes describe the 14" Spruce S55W 8.13 ft. corner monument as a wood post referenced by: 11" Hemlock N49W 11.98 ft. 8" Sugar S72E, 36 1 9" White Birch S68E 13.10 ft. 14" Hemlock N53W, 38 1 12" Maple S07E 22.81 ft. LS RC, Pg. 153.

B. Description of corner evidence found and/or method applied in restoring or reestablishing corner:

1993 - Found a iron and cap with LS #'s 15413 and 25836 replaced with Marquette County Survey Monument. The surveyor's notes who placed the corner were examined and it was the peer group's consensus that a reasonable and prudent job was performed in establishing this corner according to original G.L.O. evidence and the corner position was accepted. Peer group ratification 11-29-93.

C. Description of monument for corner and accessories established to perpetuate locating the position of the corner:

1993 - Replaced iron with LS cap #15413 & #25836 with 2 1/8" diameter aluminum pipe capped with 3 1/4" diameter aluminum tablet Marquette County Survey Monument stamped to identify the corner referenced by nails in: 11" Hemlock N37W 12.03 ft. Carlson NBT 9" White Birch S65E 13.12 ft. Carlson NBT 13" Maple S16E 22.81 ft. Carlson NBT 14" Spruce S61W 8.20 ft. Carlson NBT Monument is 0.50 ft. above ground. Bk. 3, pg. 108



Signed by Gerald W. Carlson

Date 12-22-93

Surveyor's Michigan License No. 24589