

JOB NUMBER: 93300  
 SHEET NO. : 1-340  
 For corners in

**COMMISSION LAND CORNER RECORDATION CERTIFICATE**  
**Filing Requirement of Act 74, Mich. P.A. 1970**

MARQUETTE COUNTY  
 RECEIVED DEEDS  
 1993 DEC 22 PM 4:15  
 REGISTER OF DEEDS  
 LIBER 15 R.C. PAGE 20  
 REGISTER OF DEEDS STAMP & FILE NUMBER

<u>MARQUETTE</u> (County)		Located In:	Corner Code #
1. Public Land Survey	T 48N R 25W	A-8	
	T 48N R 26W	M-8	✓
	T R		
	T R		
2. Property Controlling in Section	S T R		
	S T R		
3. Miscellaneous Property in Sec.	S T R		
	S T R		

4. Lot No. \_\_\_\_\_, Recorded Plat \_\_\_\_\_  
 5. Private Claims \_\_\_\_\_

	A	B	C	D	E	F	G	H	I	J	K	L
2	6	5	4	3	2	1						
3												
4	7	8	9	10	11	12						
5												
6	18	17	16	15	14	13						
7												
8	19	20	21	22	23	24						
9												
10	30	29	28	27	26	25						
11												
12	31	32	33	34	35	36						
13												

I, GERALD W. CARLSON, in a field survey on Monday, December 6, 1993, do hereby certify that under requirements of P.A. 74, Michigan P.A. of 1970, the corner points mentioned in lines 1 and 2 above were in conformance with regulations and rules therefore as required in the current manual of survey instructions of the United States Department of the Interior, Bureau of Land Management or by a decree of a Court of Law and/or that the corner points mentioned in lines 3, 4 and 5 above were in conformance with the rules of the Michigan Board of Land Surveyors or by a Decree of a Court of Law; established, re-established, monumented, re-monumented, recovered, found as expressed below:

**NOTE: Not more than 4 corners, all in the same town and range, may be recorded on this certificate.**

**A. Description of original monument and accessories and/or subsequent restoration:**

A-8: Quarter Corner common to Section 19, T48N-R25W and Section 24, T48N-R26W. 1845: William A. Burt's original survey notes describe the corner monument as a wood post referenced by:	1979- C.F. Clark recorded a 1" square iron pin and nails and tags in:
12" Sugar S83W, 25 l	10" Maple S70E 9.50 ft.
20" Y. Birch N25W, 25 l	4" Maple S05W 5.65 ft.
	7" Maple S85W 6.25 ft. (MDSH US-41 plans, Fed. proj. #P (108) 3; 1953, 56) and set new witnesses by nails and tags in:
	(See reverse side)

**B. Description of corner evidence found and/or method applied in restoring or reestablishing corner:**


1993 - Found 1" square iron pin. Distance to SW corner of Section 19 checked with Assessor's Plat of Northwoods Lane Acres. Replaced 1" square iron pin with a Marquette County Survey Monument placed on 6.0' long 3/4" rebar driven to solid ground in marshy area. Peer group ratification 11-29-93.

**C. Description of monument for corner and accessories established to perpetuate locating the position of the corner:**

1993 - Replaced 1" square iron pin with a 3 1/4" diameter aluminum tablet Marquette County Survey Monument placed on a 6.0' ft. long 3/4" rebar driven to solid ground stamped to identify the corner referenced by nails in:

4" Oak N22E 7.52 ft. Van Neste NBT
12" Maple S21W 6.34 ft. Clark, Van Neste NBT
7" Oak S48W 21.02 ft.
11" Maple N84W 25.68 ft. Clark, Van Neste NBT

Monument is 0.30 feet above ground.  
 Bk. 3, Pg. 144

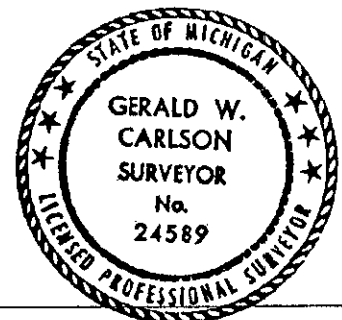

Signed by Gerald W. Carlson Date 12-22-93  
 Surveyor's Michigan License No. 24589

Record No. 340

# 9873  

Part "A" Continued:

6" Balsam stump	N20W	3.23 ft.
12" Maple	West	24.74 ft.
10" Maple	S12W	6.03 ft.
L1 RC, Pg. 363		

1980 - Corner shown on the recorded plat of the Assessor's Plat Northwoods Lane Acres, no corner accessories given.

1990 - G. Van Neste recorded a found 1" square steel pin.

1/2" rerod in		
C/L old Hwy.41	AZ. 358°	41.03'
12" Maple	AZ 273 1/2°	25.49 ft.
12" Maple	AZ 210°	6.25 ft.
3" Oak	AZ 23°	7.35 ft.

All trees blazed and witnessed with nails and washers "Van Neste Surveying".  
L5 RC, Pg. 298.