

1998

LAND CORNER RECORDATION CERTIFICATE
Filing Requirement of Act 74, Mich. P.A. 1970

MARQUETTE COUNTY
LUDINGAN
RECEIVED FOR RECORD

1998 FEB 12 PM 3:34

For corners in

SECTION

MARQUETTE

(County)

Located In:

Ishpeming Township

Corner Code #

Table with 3 columns: Description, Township/Range, Corner Code #. Includes entries for Public Land Survey, Property Controlling in Section, and Miscellaneous Property in Sec.

Handwritten signature and REGISTER OF DEEDS stamp

LIBER R2 PAGE 148

Register of Deeds Stamp & File Number

4. Lot No. , Recorded Plat
5. Private Claims

I, George M. Platz, in a field survey on December 7, 1998 do hereby state that under requirements of P.A. 74, Michigan P.A. of 1970, the corner points mentioned in lines 1 and 2 above were in conformance with regulations and rules therefore as required in the current manual of survey instructions of the United States Department of the Interior, Bureau of Land Management or by a decree of a Court of Law and/or that the corner points mentioned in lines 3, 4 and 5 above were in conformance with the rules of the Michigan Board of Land Surveyors or by a Decree of a Court of Law; established, re-established, monumented, recovered, found as expressed below:

Grid table with columns A-L and rows 1-13. Cell B1 contains a dot.

NOTE: Not more than 2 corners, all in the same town and range, may be recorded on this certificate.

1/4 corner common to: Section 6 T.48N., R.27W.
Section 31 T.49N., R.27W.

RATIFIED BY PEER GROUP
P.A. 345 OF 1990

A. Description of original monument and accessories and/or subsequent restoration:

1846: Original US Government Survey by Austin Burt - Set wood post witnessed by: N54°W 28 links; 8" Spruce

Handwritten signature and DATE 12/7/98

1916 -1918: Section corner coordinate information from Cleveland Cliffs Iron Company indicates the corner to be an iron pipe. No additional information given.

1939: Marquette County Road Commission field notes. Found iron pipe.


B. Description of corner evidence found and/or method applied in restoring or reestablishing corner:

Found 1 1/2" iron pipe. No evidence of original B.T.'s could be found. A thorough search found no evidence of any other survey monumentation or occupation in the immediate area. The position of this corner has been used and accepted by others as evidenced by line markings. The distance measured between this point and the S 1/4 of section 6 is 5278.4'. The M.C.R.C. distance from their 1939 field notes is 5278.5'. Any relevant GLO line calls which could help verify the position of this point were forever changed by the flooding of the Dead River Basin area. All measurements obtainable recorded survey information and any other obtained unrecorded survey information made available to Spalding DeDecker Associates is documented in the research dossier. Considering the above information, all known evidence favor the correctness of this point.

C. Description of monument for corner and accessories established to perpetuate locating the position of the corner:

Replaced found 1 1/2" iron pipe with standard Marquette County Remonumentation Monument, being a 2 3/8" diameter x 30" aluminum post with 3 1/4" diameter aluminum cap stamped with appropriate corner identification and 1998, PLATZ 38121". Made the following new witnesses:

- Az. 14° 23.41'; Set Mag nail w/tag No.38121 in E. face of 8" Balsam
Az. 42° 10.73'; Set Mag nail w/tag No.38121 in S. face of 16" Balsam with BT tag affixed
Az. 110° 10.89'; Set Mag nail w/tag No.38121 in S. face of 9" Balsam
Az. 230° 7.62'; Set Mag nail w/tag No.38121 in N.W. face of 10" Balsam

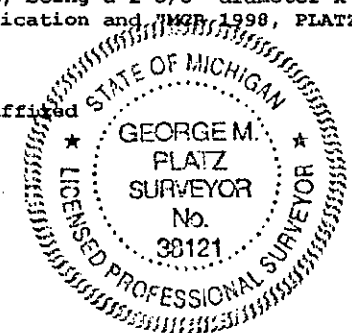

Signed by George M. Platz

Date 12-30-98

Surveyor's Michigan License No. 38121