

LAND CORNER RECORDATION CERTIFICATE
Filing Requirement of Act 74, Mich. P.A. 1970

For corners in SECTION 4

<u>MARQUETTE</u> (County)	Located In: Ishpeming Township	Corner Code #
1. Public Land Survey	<u>T48N R27W</u>	<u>E-02</u>
	T _____ R _____	_____
	T _____ R _____	_____
	T _____ R _____	_____
2. Property Controlling in Section	S _____ T _____ R _____	_____
	S _____ T _____ R _____	_____
3. Miscellaneous Property in Sec.	S _____ T _____ R _____	_____
	S _____ T _____ R _____	_____

MARQUETTE COUNTY
 REGISTERED FOR RECORD
 1999 FEB 12 PM 3:34

Patricia A. Monkey
 REGISTER OF DEEDS

LIBER **R2** PAGE **154**
 Register of Deeds Stamp & File Number

4. Lot No. _____, Recorded Plat _____
 5. Private Claims _____

I, George M. Platz, in a field survey on December 7, 1998 do hereby state that under requirements of P.A. 74, Michigan P.A. of 1970, the corner points mentioned in lines 1 and 2 above were in conformance with regulations and rules therefore as required in the current manual of survey instructions of the United States Department of the Interior, Bureau of Land Management or by a decree of a Court of Law and/or that the corner points mentioned in lines 3, 4 and 5 above were in conformance with the rules of the Michigan Board of Land Surveyors or by a Decree of a Court of Law; established, re-established, monumented, recovered, found as expressed below:

	A	B	C	D	E	F	G	H	I	J	K	L	M
1													
2	6			5	●	4		3		2		1	
3													
4	7			8		9		10		11		12	
5													
6	18			17		16		15		14		13	
7													
8	19			20		21		22		23		24	
9													
10	30			29		28		27		26		25	
11													
12	31			32		33		34		35		36	
13													

NOTE: Not more than 2 corners, all in the same town and range, may be recorded on this certificate.

1/4 corner common to: Sections 4 T.48N, R.27W.
 Sections 5 T.48N, R.27W.

A. Description of original monument and accessories and/or subsequent restoration:

1848: Original US Government Survey by Wells Burt - Set wood post witnessed by:
 N58°W 32 Links; 14" Spruce
 S70.5°E 54 links; 10" Spruce

RATIFIED BY PEER GROUP
 P.A. 345 OF 1990

Luigi J. Pizzone
 DATE 1/21/98


B. Description of corner evidence found and/or method applied in restoring or reestablishing corner:

A thorough search of the area found a 1" iron bar about ten feet north of a tree cut line that runs in an east west direction. No evidence of original B.T.'s could be found. No recorded survey information exists in the Marquette County Register of Deeds. No unrecorded survey information has been made available to Spalding DeDecker Associates. Any relevant line calls that could help verify the position of this point were forever changed by the flooding of the Dead River Basin. All measurements, obtainable recorded survey information and any other obtained unrecorded survey information made available to Spalding DeDecker Associates, Inc. is documented in the research dossier. Although a case could be made for relocating this point about ten feet southerly to better fit apparent tree cutting (occupation?), it has been determined that without additional data, the relocation of this point is not now justified. Considering the above information, all known evidence favors the correctness of this point.

C. Description of monument for corner and accessories established to perpetuate locating the position of the corner:

Replaced found 1" iron bar with standard Marquette County Remonumentation Monument, being a 2 3/8" diameter x 30" aluminum post with 3 1/4" diameter aluminum cap stamped with appropriate corner identification and "MCR 1998, PLATZ 38121". Made the following new witnesses:

- Az. 20° 5.67'; Set mag nail w/tag No.38121 in W face of 10" stump
- Az. 103° 17.15'; Set mag nail w/tag No.38121 in N face of 7" Spruce
- Az. 175° 9.63'; Set mag nail w/tag No.38121 in W face of 8" Spruce with B.T. tag affixed
- Az. 250° 18.02'; Set mag nail w/tag No.38121 in S face of 6" Spruce

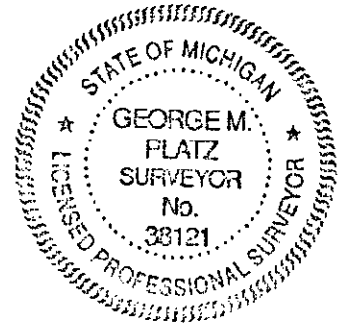

Signed by George M. Platz

Date 12-30-98

Surveyor's Michigan License No. 38121