

LAND CORNER RECORDATION CERTIFICATE
Filing Requirement of Act 74, Mich. P.A. 1970

MARQUETTE COUNTY
 MICHIGAN
 RECEIVED FOR RECORD

1999 FEB 12 PM 3:34

Richard A. Mandley
 REGISTER OF DEEDS

For corners in

<u>MARQUETTE</u> (County)	Located In: Ishpeming Township	Corner Code # F-03
1. Public Land Survey	T <u>48N</u> R <u>27W</u>	
	T _____ R _____	
	T _____ R _____	
	T _____ R _____	
2. Property Controlling in Section	S _____ T _____ R _____	
	S _____ T _____ R _____	
3. Miscellaneous Property in Sec.	S _____ T _____ R _____	
	S _____ T _____ R _____	

LIBER **R2** PAGE **155**
 Register of Deeds Stamp & File Number

4. Lot No. _____, Recorded Plat _____
 5. Private Claims _____

	A	B	C	D	E	F	G	H	I	J	K	L	M
1													
2	6		5			4		3		2			1
3						●							
4	7		8			9		10		11			12
5													
6	18		17			16		15		14			13
7													
8	19		20			21		22		23			24
9													
10	30		29			28		27		26			25
11													
12	31		32			33		34		35			36
13													

I, George M. Platz, in a field survey on December 7, 1998 do hereby state that under requirements of P.A. 74, Michigan P.A. of 1970, the corner points mentioned in lines 1 and 2 above were in conformance with regulations and rules therefore as required in the current manual of survey instructions of the United States Department of the Interior, Bureau of Land Management or by a decree of a Court of Law and /or that the corner points mentioned in lines 3, 4 and 5 above were in conformance with the rules of the Michigan Board of Land Surveyors or by a Decree of a Court of Law; established, re-established, monumented, recovered, found as expressed below:

NOTE: Not more than 2 corners, all in the same town and range, may be recorded on this certificate.

1/4 corner common to: Sections 4 T.48N., R.27W.
 Sections 9 T.48N., R.27W.

RATIFIED BY PEER GROUP
 P.A. 345 OF 1990

Larry J. Bussone
 DATE 12/14/98

A. Description of original monument and accessories and/or subsequent restoration:

1848: Original US Government Survey by Wells Burt - Set wood post witnessed by:
 S20°E 13 Links; 10" Spruce
 N15°E 26 Links; 9" Spruce

1987: Survey (unrecorded) and survey computation sheet for breakdown of section 9 by Larry Bussone, PS 25833. Bussone set a 1" iron from the remains of an original 10" Spruce B.T. (Now a stump in poor condition) Witnessed by:
 N3°W 13.6'; nail in 8" Spruce
 N60°E 13.7'; nail in 8" Spruce
 S88°E 11.5'; nail in 7" J Pine
 N82°W 15.2'; nail in 4" Spruce


B. Description of corner evidence found and/or method applied in restoring or reestablishing corner:

Found 1" iron as described in unrecorded survey by Larry Bussone, PS 25833. This corner was re-established from remains of the original 10" Spruce B.T. and a line call to the edge of a swamp at 40.50 chains. A thorough search found no evidence of any other monumentation or occupation in the immediate area. All measurements, obtainable recorded survey information and any other obtained unrecorded survey information made available to Spalding DeDecker Associates is documented in the research dossier. Considering the above information, all known evidence favors accepting the position of this point.

C. Description of monument for corner and accessories established to perpetuate locating the position of the corner:

Replaced 1" iron bar with standard Marquette County Remonumentation Monument, being a 2 3/8" diameter x 30" aluminum post with 3 1/4" diameter aluminum cap stamped with appropriate corner identification and "MCR 1998, PLATZ 38121". Made the following new witnesses:

- Az. 64° 14.25'; Set mag nail w/tag No.38121 in NW face of 10" Spruce
- Az. 102° 11.86'; Set mag nail w/tag No.38121 in N face of 10" Spruce with B.T. tag affixed
- Az. 131° 4.71'; Set mag nail w/tag No.38121 in N face of 8" Spruce
- Az. 355° 13.94'; Set mag nail w/tag No.38121 in W face of 10" Spruce

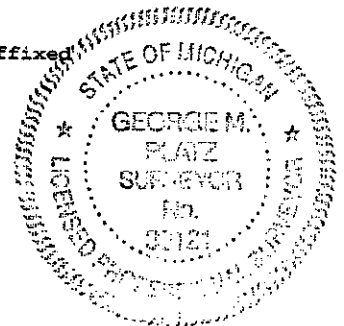

Signed by George M. Platz
 Surveyor's Michigan License No. 38121

Date 12-30-98