

JOB NUMBER: 93300  
SHEET NO. : 1-391  
For corners in

**LAND CORNER RECORDATION CERTIFICATE**  
Filing Requirement of Act 74, Mich. P.A. 1970

Located In: \_\_\_\_\_ Corner Code # \_\_\_\_\_

1. Public Land Survey  
 T 47N R 27W P-1  
 T 48N R 27W P-13 ✓  
 T \_\_\_\_\_ R \_\_\_\_\_  
 T \_\_\_\_\_ R \_\_\_\_\_

2. Property Controlling in Section  
 S \_\_\_\_\_ T \_\_\_\_\_ R \_\_\_\_\_  
 S \_\_\_\_\_ T \_\_\_\_\_ R \_\_\_\_\_

3. Miscellaneous Property in Sec.  
 S \_\_\_\_\_ T \_\_\_\_\_ R \_\_\_\_\_  
 S \_\_\_\_\_ T \_\_\_\_\_ R \_\_\_\_\_

4. Lot No. \_\_\_\_\_, Recorded Plat \_\_\_\_\_

5. Private Claims \_\_\_\_\_

 RECEIVED FOR RECORDATION  
 1993 DEC 29 AM 10:44  
 LIBER 1 PAGE 79  
 Register of Deeds Stamp & File Number

I, GERALD W. CARLSON, in a field survey on Thursday, December 23, 1993, do hereby certify that under requirements of P.A. 74, Michigan P.A. of 1970, the corner points mentioned in lines 1 and 2 above were in conformance with regulations and rules therefore as required in the current manual of survey instructions of the United States Department of the Interior, Bureau of Land Management or by a decree of a Court of Law and/or that the corner points mentioned in lines 3, 4 and 5 above were in conformance with the rules of the Michigan Board of Land Surveyors or by a Decree of a Court of Law; established, re-established, monumented, re-monumented, recovered, found as expressed below:

	A	B	C	D	E	F	G	H	I	J	K	L	M
2	6	5	4	3	2	1							
3													
4	7	8	9	10	11	12							
5													
6	18	17	16	15	14	13							
7													
8	19	20	21	22	23	24							
9													
10	30	29	28	27	26	25							
11													
12	31	32	33	34	35	36							
13													

**NOTE: Not more than 4 corners, all in the same town and range, may be recorded on this certificate.**

**A. Description of original monument and accessories and/or subsequent restoration:**


F-1: Quarter Corner common to Section 4, T47N-R27W and Section 33, T48N-R27W. 1846: Austin Burt's original survey with coordinates N191.58, W23596.98. No description of the notes describe the corner monument as a Spruce post monument or corner accessories given. referenced by:  
 6" Maple N50.5E, 35 1  
 8" Spruce N11W, 45 1

**B. Description of corner evidence found and/or method applied in restoring or reestablishing corner:**

1993 - Found 12" diameter Cummings mushroom at the intersection at the old fence line South and the rock pile fence West. Left iron mushroom as found. Peer group ratification 12-20-93.

**C. Description of monument for corner and accessories established to perpetuate locating the position of the corner:**

1993 - Found 12" diameter capped iron mushroom set by C.P. Cummings in June 1892 with raised letters to identify the corner referenced by nails in:  
 5" Jack Pine S75W 79.66 ft.  
 6" Cherry N12E 24.49 ft.  
 10" Cherry S90E 22.35 ft.  
 8" White Pine S12W 37.24 ft.  
 Corner falls at corner of rock fence lines to the West and South on side of a hill that slopes up to the Southeast.  
 Bk. 5, Pg. 22

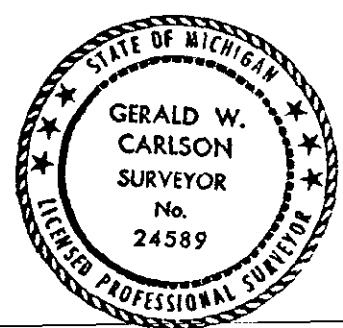

Signed by Gerald W. Carlson Date 12-23-93

Surveyor's Michigan License No. 24589