

**LAND CORNER RECORDATION CERTIFICATE**  
**Filing Requirement of Act 74, Mich. P.A. 1970**

For corners in

SECTION

MARQUETTE  
(County)

Located In: Ishpeming Township

Corner Code #

- |                                    |             |             |             |
|------------------------------------|-------------|-------------|-------------|
| 1. Public Land Survey              | <u>T48N</u> | <u>R27W</u> | <u>G-02</u> |
|                                    | T           | R           |             |
|                                    | T           | R           |             |
|                                    | T           | R           |             |
| 2. Property Controlling in Section | S           | T           | R           |
|                                    | S           | T           | R           |
| 3. Miscellaneous Property in Sec.  | S           | T           | R           |
|                                    | S           | T           | R           |

MARQUETTE COUNTY  
MICHIGAN  
RECEIVED FOR RECORD

1999 FEB 12 PM 3:34

*Richard D. Mankley*  
REGISTERED DEEDS  
LIBER **R2** PAGE **156**  
Register of Deeds Stamp & File Number

4. Lot No. \_\_\_\_\_, Recorded Plat \_\_\_\_\_  
 5. Private Claims \_\_\_\_\_

I, George M. Platz, in a field survey on December 7, 1998 do hereby state that under requirements of P.A. 74, Michigan P.A. of 1970, the corner points mentioned in lines 1 and 2 above were in conformance with regulations and rules therefore as required in the current manual of survey instructions of the United States Department of the Interior, Bureau of Land Management or by a decree of a Court of Law and /or that the corner points mentioned in lines 3, 4 and 5 above were in conformance with the rules of the Michigan Board of Land Surveyors or by a Decree of a Court of Law; established, re-established, monumented, recovered, found as expressed below:

**NOTE: Not more than 2 corners, all in the same town and range, may be recorded on this certificate.**

1/4 corner common to: Sections 3 T.48N., R.27W.  
 Sections 4 T.48N., R.27W.

	A	B	C	D	E	F	G	H	I	J	K	L	M
1													
2		6		5		4	●	3		2		1	
3													
4		7		8		9		10		11		12	
5													
6		18		17		16		15		14		13	
7													
8		19		20		21		22		23		24	
9													
10		30		29		28		27		26		25	
11													
12		31		32		33		34		35		36	
13													

RATIFIED BY PEER GROUP  
 P.A. 345 OF 1990

*Larry J. Brune*  
 DATE 12/14/98

**A. Description of original monument and accessories and/or subsequent restoration:**

1848: Original US Government Survey by Wells Burt - Set wood post witnessed by:  
 N57°W 14 Links 9" Spruce  
 S74°E 22 Links 8" W Pine

1916 - 1918: Section corner coordinate information from Cleveland Cliffs Iron Company indicates the corner to be a "standard" brass capped monument. No additional information given.


**B. Description of corner evidence found and/or method applied in restoring or reestablishing corner:**

Found 1-1/2" diameter galvanized iron pipe with "standard" brass cap, 24"+/- above ground. A thorough search found no evidence of any other survey monumentation or occupation in the immediate area. The position of the corner has been used and accepted by others as evidenced by line markings. No evidence of original B.T.'s could be found. Original GLO line calls are not distinctive enough to verify the position of this point. All measurements, obtainable recorded survey information and any other obtained unrecorded survey information made available to Spalding DeDecker Associates is documented in the research dossier. Considering the above information, all known evidence favors the correctness of this point.

**C. Description of monument for corner and accessories established to perpetuate locating the position of the corner:**

Accepted found 1 1/2" diameter galvanized iron pipe with "standard" brass cap stamped with appropriate identification. Stamped "MCR 1998" on brass cap to properly identify accepted corner. Made the following new witnesses:

- Az. 72° 26.72' Set mag nail w/tag No.38121 in S. face of 14" Pine
- Az. 152° 15.11' Set mag nail w/tag No.38121 in E. face of 18" Pine
- Az. 260° 14.15' Set mag nail w/tag No.38121 in S. Face of 17" Pine with B.T. tag affixed
- Az. 350° 42.54' Set mag nail w/tag No.38121 in W. Face of 18" Pine

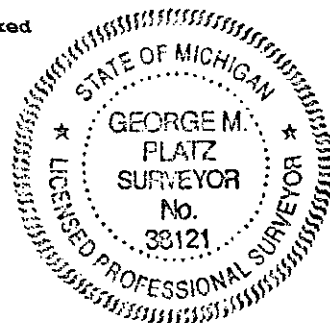

Signed by George M. Platz

Date 12-30-98

Surveyor's Michigan License No. 38121