

1993

COMMISSION

JOB NUMBER: 93300  
SHEET NO. : 1-390  
For corners in

LAND CORNER RECORDATION CERTIFICATE  
Filing Requirement of Act 74, Mich. P.A. 1970

MARQUETTE COUNTY  
MICHIGAN  
RECEIVED FOR RECORD  
1993 DEC 29 AM 10:44  
*Johnnie L. ...*

Located In: MARQUETTE (County) Corner Code #

1. Public Land Survey	T 47N R 27W	G-1
	T 48N R 27W	G-13
	T R	
	T R	
2. Property Controlling in Section	S T R	
	S T R	
3. Miscellaneous Property in Sec.	S T R	
	S T R	

4. Lot No. \_\_\_\_\_, Recorded Plat \_\_\_\_\_

5. Private Claims \_\_\_\_\_

LIBER 1 PAGE 80  
Register of Deeds Stamp & File Number

	A	B	C	D	E	F	G	H	I	J	K	L	M
2	6	5	4	3	2	1							
3													
4	7	8	9	10	11	12							
5													
6	18	17	16	15	14	13							
7													
8	19	20	21	22	23	24							
9													
10	30	29	28	27	26	25							
11													
12	31	32	33	34	35	36							
13													

I, GERALD W. CARLSON, in a field survey on Thursday, December 23, 1993, do hereby certify that under requirements of P.A. 74, Michigan P.A. of 1970, the corner points mentioned in lines 1 and 2 above were in conformance with regulations and rules therefore as required in the current manual of survey instructions of the United States Department of the Interior, Bureau of Land Management or by a decree of a Court of Law and/or that the corner points mentioned in lines 3, 4 and 5 above were in conformance with the rules of the Michigan Board of Land Surveyors or by a Decree of a Court of Law; established, re-established, monumented, re-monumented, recovered, found as expressed below:

NOTE: Not more than 4 corners, all in the same town and range, may be recorded on this certificate.

A. Description of original monument and accessories and/or subsequent restoration:

G-1: Section Corner common to Sections 3 and 4, T47N-R27W No date given - Maas coord. system indicates the coordinates and Sections 33 and 34, T48N-R27W. 1846: Austin Burt's as N167.8, W20951.21 no description of the iron or corner original survey notes describe the corner monument as a accessories were given. C.C.I. aerial coordinates Cedar post referenced by: N153.20, W20941.61.

14" Tamarack N41E. 38 l 1980 - C.F. Clark found a 12" casting (mushroom) and R.R. rail (Cummings, 1892). Referenced by P-K nails in:

7" Tamarack N74W. 25 l 4" Poplar N10W 31.73 ft. 3" Cherry N60W 15.49 ft.  
4" Cherry S30W 21.95 ft. Power Pole N60E 78.55 ft.  
1 RC., PG. 401.


B. Description of corner evidence found and/or method applied in restoring or reestablishing corner:

1993 - Found a 12" diameter Cummings mushroom monument. Left iron mushroom as found.  
Peer group ratification 12-20-93.

C. Description of monument for corner and accessories established to perpetuate locating the position of the corner:

1993 - Found 12" diameter cast iron mushroom set by C.P. Cummings in March 1882 with raised letters to identify the corner referenced by nails in:

6" Cherry N85W 15.37 ft. Clark NBT  
6" Poplar N16W 53.99 ft.  
Power Pole N60E 78.47 ft. Clark NBT  
8" Cherry S30W 21.95 ft. Clark NBT  
5.0 ft. tall R.R. rail N34E 0.6 ft.  
Corner falls in flat brushy area NW of the Carp River.  
Bk. 5, Pg. 24

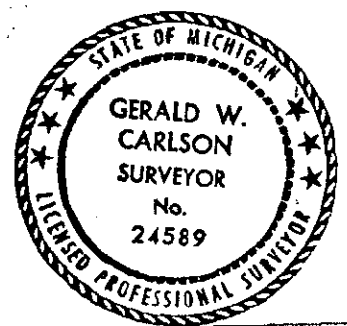

Signed by Gerald W. Carlson Date 12-28-93

Surveyor's Michigan License No. 24589