

SECTION

LAND CORNER RECORDATION CERTIFICATE
Filing Requirement of Act 74, Mich. P.A. 1970

For corners in

Form with fields for MARQUETTE (County), Located In: Ishpeming Township, Corner Code # J-03, and numbered sections 1-5 for survey details.

MARQUETTE COUNTY MICHIGAN RECEIVED FOR RECORD 1998 FEB 12 PM 3:34

Signature of Patricia A. Monahan, REGISTER OF DEEDS

LIBER R2 PAGE 163 Register of Deeds Stamp & File Number

I, George M. Platz, in a field survey on December 7, 1998 do hereby state that under requirements of P.A. 74, Michigan P.A. of 1970, the corner points mentioned in lines 1 and 2 above were in conformance with regulations and rules therefore as required in the current manual of survey instructions of the United States Department of the Interior, Bureau of Land Management or by a decree of a Court of Law and/or that the corner points mentioned in lines 3, 4 and 5 above were in conformance with the rules of the Michigan Board of Land Surveyors or by a Decree of a Court of Law; established, re-established, monumented, recovered, found as expressed below:

NOTE: Not more than 2 corners, all in the same town and range, may be recorded on this certificate.

Grid table with columns A-M and rows 1-13. A dot is marked at the intersection of column J and row 3.

1/4 corner common to: Section 2 T.48N., R.27W. Section 11 T.48N., R.27W.

RECORDED BY PEER GROUP, P.A. 345 OF 1990

A. Description of original monument and accessories and/or subsequent restoration:

Signature of Larry J. Pursell, DATE 12/14/98

1846: Original US Governmental Survey by Wells Burt - Set wood post witnessed by: N29°E 18 links; 10" W Pine S70°W 35 links; 24" W Pine

1916 - 1918: Section corner coordinate information from Cleveland Cliffs Iron Company indicates the corner to be a iron pin. No additional information given.


B. Description of corner evidence found and/or method applied in restoring or reestablishing corner:

Found 1-1/4" solid iron bar 12"+/- above ground. A thorough search found no evidence of any other survey monumentation or occupation in the immediate area. The position of the corner has been used and accepted by others as evidenced by line markings. No evidence of original B.T.'s could be found. Any relevant GLO line calls which could help verify the position of this point were forever changed by the flooding of the Dead River Basin Area. All measurements, obtainable recorded survey information and any other obtained unrecorded survey information made available to Spalding DeDecker Associates is documented in the research dossier. Considering the above information, all known evidence favors the correctness of this point.

C. Description of monument for corner and accessories established to perpetuate locating the position of the corner:

Replaced found 1 1/4" iron bar with standard Marquette County Remonumentation Monument, being a 2 3/8" diameter x 30" aluminum post with 3 1/4" diameter aluminum cap stamped with appropriate corner identification and "MCR 1998, PLATZ 38121". Made the following new witnesses:

- Az. 25° 11.20'; Set Mag nail w/tag no.38121 in the SE face of 4" Birch
Az. 70° 11.30'; Set Mag nail w/tag no.38121 in the N face of 4" Birch
Az.160° 13.80'; Set Mag nail w/tag no.38121 in the NE face of 4" Birch
Az.220° 21.00'; Set Mag nail w/tag no.38121 in the SE face of 6" White Birch with B.T. tag as shown

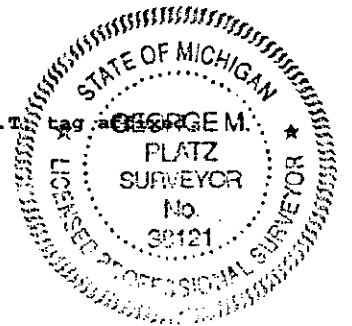

Signed by George M. Platz, Surveyor's Michigan License No. 38121

Date 12-30-98