

LAND CORNER RECORDATION CERTIFICATE
Filing Requirement of Act 74, Mich. P.A. 1970

MARQUETTE COUNTY
 MICHIGAN
 RECEIVED FOR RECORD
 1999 FEB 12 PM 3:31

For corners in SECTION

<u>MARQUETTE</u> (County)	Located In: Ishpeming Township	Corner Code #
1. Public Land Survey	T <u>48N</u> R <u>27W</u>	<u>K-01</u> ✓
	T <u>49N</u> R <u>27W</u>	<u>K-13</u>
	T_____ R_____	_____
	T_____ R_____	_____
2. Property Controlling in Section	S_____ T_____ R_____	_____
	S_____ T_____ R_____	_____
3. Miscellaneous Property in Sec.	S_____ T_____ R_____	_____
	S_____ T_____ R_____	_____

Richard B. Morley
 REGISTER OF DEEDS

LIBER **R2** PAGE **164**
 Register of Deeds Stamp & File Number

4. Lot No. _____, Recorded Plat _____
 5. Private Claims _____

I, George M. Platz, in a field survey on December 7, 1998 do hereby state that under requirements of P.A. 74, Michigan P.A. of 1970, the corner points mentioned in lines 1 and 2 above were in conformance with regulations and rules therefore as required in the current manual of survey instructions of the United States Department of the Interior, Bureau of Land Management or by a decree of a Court of Law and /or that the corner points mentioned in lines 3, 4 and 5 above were in conformance with the rules of the Michigan Board of Land Surveyors or by a Decree of a Court of Law; established, re-established, monumented, recovered, found as expressed below:

A	B	C	D	E	F	G	H	I	J	K	L	M
1												
2	6	5	4	3	2	1						
3												
4	7	8	9	10	11	12						
5												
6	18	17	16	15	14	13						
7												
8	19	20	21	22	23	24						
9												
10	30	29	28	27	26	25						
11												
12	31	32	33	34	35	36						
13												

NOTE: Not more than 2 corners, all in the same town and range, may be recorded on this certificate.

Section corner common to: Section 1 T.48N., R.27W.
 Section 2 T.48N., R.27W.
 Section 35 T.49N., R.27W.
 Section 36 T.49N., R.27W.

A. Description of original monument and accessories and/or subsequent restoration:

1846: Original US Government Survey by Austin Burt - Set wood post witnessed by:
 East 19 links; 14" Cedar
 N7°W 39 links; 18" Cedar

1916 - 1918: Section corner coordinate information from Cleveland Cliffs Iron Company indicates the corner to be a "standard" brass capped monument. No additional information given.

1981: L.C.R.C. recorded in L.4 of R.C., P.146, Marquette County Records. Robert Schmeling, PS 8317 - Found 1 1/2" diameter iron pipe with "standard" brass cap. Stamped "MEAD" "RLS 8317", "1981" on cap. Witnessed by:
 N60°E 27.5'; nail in E of 5" White Cedar
 S54°E 16.2'; nail in E of 10" White Cedar
 S55°W 24.0'; nail in E of 11" Black Spruce
 N72°W 31.2'; nail in E of 11" White Cedar

RATIFIED BY PEER GROUP
P.A. 345 OF 1990
Larry J. Bussone
 DATE 12/14/98


B. Description of corner evidence found and/or method applied in restoring or reestablishing corner:

Found 1-1/2" iron pipe with "standard" brass cap, 36"+/- above ground as described in 1981 L.C.R.C. recorded in L.4 of R.C., P.146, Marquette County Records. A thorough search found no evidence of any other survey monumentation or occupation in the immediate area. The position of this corner has been used and accepted by others as evidenced by line markings. No evidence of original B.T.'s could be found. Distinct original GLO line calls to the west of this point have been forever changed by the flooding of the Dead River Basin. All measurements, obtainable recorded survey information and any other obtained unrecorded survey information made available to Spalding DeDecker Associates is documented in the research dossier. Considering the above information, all known evidence favors the correctness of this point.

C. Description of monument for corner and accessories established to perpetuate locating the position of the corner:

Accepted found 1 1/2" diameter galvanized iron pipe with "standard" brass cap. Stamped "MCR 1998, PLATZ 38121" on brass cap to properly identify accepted corner. Made the following new witnesses:

- Az. 56° 27.62' Set mag nail w/tag No.38121 in NE face of 8" Cedar
- Az. 134° 16.34' Set mag nail w/tag No.38121 in SW face of 14" Cedar with B.T. tag affixed
- Az. 232° 24.15' Set mag nail w/tag No.38121 in SE face of 14" Spruce
- Az. 280° 31.18' Set mag nail w/tag No.38121 in S face of 15" Cedar

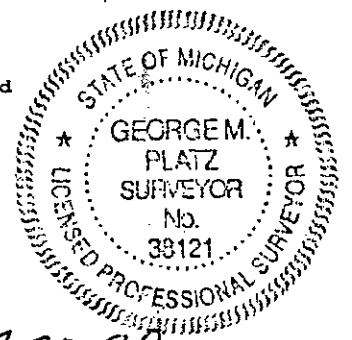

Signed by George M. Platz
 Surveyor's Michigan License No. 38121

Date 12-30-98