

1999 NOV 18 PM 2:05

LAND CORNER RECORDATION CERTIFICATE
Filing Requirement of Act 74, Mich. P.A. 1970

For corners in SECTION

<u>MARQUETTE</u> (County)	Located In: Ishpeming Township	Corner Code # <u>K-03</u>
1. Public Land Survey	T <u>48N</u> R <u>27W</u>	<u>K-03</u>
	T _____ R _____	_____
	T _____ R _____	_____
	T _____ R _____	_____
2. Property Controlling in Section	S _____ T _____ R _____	_____
	S _____ T _____ R _____	_____
3. Miscellaneous Property in Sec.	S _____ T _____ R _____	_____
	S _____ T _____ R _____	_____

Patricia H. Mankay
REGISTER OF DEEDS

LIBER **R 2** PAGE **174**

Register of Deeds Stamp & File Number

4. Lot No. _____, Recorded Plat _____
5. Private Claims _____

I, George M. Platz, in a field survey on December 7, 1998 do hereby state that under requirements of P.A. 74, Michigan P.A. of 1970, the corner points mentioned in lines 1 and 2 above were in conformance with regulations and rules therefore as required in the current manual of survey instructions of the United States Department of the Interior, Bureau of Land Management or by a decree of a Court of Law and/or that the corner points mentioned in lines 3, 4 and 5 above were in conformance with the rules of the Michigan Board of Land Surveyors or by a Decree of a Court of Law; established, re-established, monumented, recovered, found as expressed below:

NOTE: Not more than 2 corners, all in the same town and range, may be recorded on this certificate.

Section corner common to:
Section 1 T.48N., R.27W.
Section 2 T.48N., R.27W.
Section 11 T.48N., R.27W.
Section 12 T.48N., R.27W.

A. Description of original monument and accessories and/or subsequent restoration:

1848: Original US Government Survey by Wells Burt - Set wood post witnessed by:
N31°E 21 Links; 6" Maple
N59.5°W 31 Links; 14" W Birch

RATIFIED BY PEER GROUP
P.A. 345 OF 1990

Harry J. Buswell
DATE 12/15/98

1	A	B	C	D	E	F	G	H	I	J	K	L	M
2		6		5		4		3		2		1	
3													
4		7		8		9		10		11		12	
5													
6		18		17		16		15		14		13	
7													
8		19		20		21		22		23		24	
9													
10		30		29		28		27		26		25	
11													
12		31		32		33		34		35		36	
13													


B. Description of corner evidence found and/or method applied in restoring or reestablishing corner:

A thorough search found no evidence of any survey monumentation or occupation in the immediate area. No recorded survey information exists in the Marquette County Register of Deeds and no unrecorded survey information could be obtained regarding this corner. No evidence of original B.T.'s could be found. Original GLO line calls which could help redefine this corner are inconsistent within themselves in the field and appear unreliable. Considering the above information, we have physically established the section corner common to sections 1, 2, 11 and 12 by double proportionate measurement, per original GLO notes, between adjacent section corners.

C. Description of monument for corner and accessories established to perpetuate locating the position of the corner:

Set standard Marquette County Remonumentation Monument, being a 2 3/8" diameter x 30" aluminum post with 3 1/4" diameter aluminum cap stamped with appropriate corner identification and "1998, PLATZ, 38121". Made the following new witnesses:

Az. 85° 2.06'; Set mag nail w/tag No.38121 in N. face of 5" Spruce.
Az. 150° 11.70'; Set mag nail w/tag No.38121 in S.W. face of 18" Maple w/B.T. tag affixed.
Az. 217° 4.59'; Set mag nail w/tag No.38121 in N.W. face of 4" Spruce.
Az. 340° 9.17'; Set mag nail w/tag No.38121 in N. face of 4" Spruce.

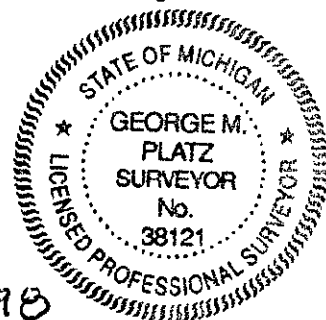

Signed by George M. Platz

Date 12-30-98

Surveyor's Michigan License No. 38121