

LAND CORNER RECORDATION CERTIFICATE
Filing Requirement of Act 74, Mich. P.A. 1970

MARQUETTE COUNTY
 MICHIGAN
 RECEIVED FOR RECORD

1999 FEB 12 PM 3:33

Patricia K. Monbey
 REGISTER OF DEEDS

LIBER **R2** PAGE **137**
 Register of Deeds Stamp & File Number

For corners in

SECTION

<u>MARQUETTE</u> (County)	Located In: Negaunee Township	Corner Code #
1. Public Land Survey	T48N R26W T48N R27W T____ R____ T____ R____	A-02 M-02 ✓ _____ _____
2. Property Controlling in Section	S____ T____ S____ T____ S____ T____	_____ _____ _____
3. Miscellaneous Property in Sec.	S____ T____ S____ T____	_____ _____

4. Lot No. _____, Recorded Plat _____
 5. Private Claims _____

, George M. Platz, in a field survey on December 7, 1998 do hereby state that under requirements of P.A. 74, Michigan P.A. of 1970, the corner points mentioned in lines 1 and 2 above were in conformance with regulations and rules therefore as required in the current manual of survey instructions of the United States Department of the Interior, Bureau of Land Management or by a decree of a Court of Law and /or that the corner points mentioned in lines 3, 4 and 5 above were in conformance with the rules of the Michigan Board of Land Surveyors or by a Decree of a Court of Law; established, re-established, monumented, recovered, found as expressed below:

NOTE: Not more than 2 corners, all in the same town and range, may be recorded on this certificate.

1/4 corner common to: Section 6 T.48N., R.26W.
 Section 1 T.48N., R.27W.

1	A	B	C	D	E	F	G	H	I	J	K	L	M
2	6			5		4		3		2		1	
3													
4	7			8		9		10		11		12	
5													
6	18			17		16		15		14		13	
7													
8	19			20		21		22		23		24	
9													
10	30			29		28		27		26		25	
11													
12	31			32		33		34		35		36	
13													

A. Description of original monument and accessories and/or subsequent restoration:

1844: Original U.S. Government Survey by Austin Burt - Set wood post witnessed by:
 S45°W 19 Links; 7" Maple
 N82°W 17 Links; 5" Maple

1916 - 1918: Section corner coordinate information from Cleveland Cliffs Iron Company indicates the corner to be a "standard" brass capped monument. No additional information given.

1982: Gerald Carlson PS 24589 found 1-1/4" iron pipe with brass cap (un-recorded) Source: Mead Paper notes. Witnessed by:
 WBR 5 S83°E 10.91'
 RMP 4 S47°W 9.01'
 BSP 9 S84°W 14.21'
 CDR 3 N25°E 18.33'


B. Description of corner evidence found and/or method applied in restoring or reestablishing corner:

Found 1-1/2" iron pipe with "standard" brass cap, 24" +/- above ground, from remaining witnesses as delineated on 1982 Mead Paper notes. A thorough search found no evidence of any other survey monumentation or occupation in the immediate area. No evidence of original B.T.'s could be found. Original GLO line calls to natural features measure as follow:
 South 1041' (R) 977' (M) Top of Rock
 South 1188' (R) 1176' (M) Top of Rock
 North 1254' (R) 1293' (M) River (Dry)
 All measurements, obtainable recorded survey information and any other obtained unrecorded survey information made available to Spalding DeDecker Associates is documented in the research dossier. Considering the above information, all known evidence favors the correctness of this point.

C. Description of monument for corner and accessories established to perpetuate locating the position of the corner:

Accepted found 1-1/2" iron pipe with "standard" brass cap. Stamped "MCR 1998" on cap to properly identify the accepted corner. Made the following new witnesses:

Az. 18° 17.91'; Set mag nail w/tag No.38121 in W. face 4" Cedar.
 Az. 115° 4.21'; Set mag nail w/tag No.38121 in N. face of NW twin of 5" Maple.
 Az. 282° 9.89'; Set mag nail w/tag No.38121 in S. face 5" Maple.
 Az. 347° 21.31'; Set mag nail w/tag No.38121 in E. face 14" Pine with B.T. tag affixed.

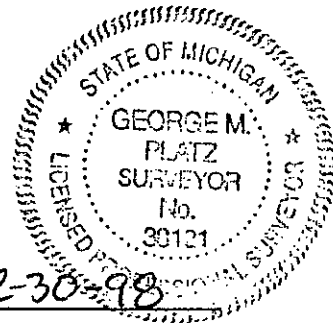

Signed by George M. Platz

Date 12-30-98

Surveyor's Michigan License No. 38121